

Date: March 22, 2021

To: All Plan Holders

RE: Roof Replacement at Lago Vista Middle School

Lago Vista Independent School District

RFCSP NO. 20210301 EE Project No. 122-001



ADDENDUM NO. 1

This addendum applies to the Contract Documents issued for the subject Project and Request for Competitive Sealed Proposals, prepared by Engineered Exteriors, LLC, dated March 3, 2021. This Addendum shall be included as part of the Contract Documents.

PLANHOLDER QUESTIONS/CLARIFICATIONS

Question	Response
I understand this is a "prevailing wage rate" project. Is certified payroll required?	We will NOT require certified payroll, but may choose to spot check those payroll figures to make sure we are abiding by those prevailing wage rates.
In Section 07 61 00, Paragraph 2.1 (Materials), Item A.2, Peterson Aluminum's PAC T-250 panel is approved but after discussing with the factory, they only offer up to an 18" wide panel in that form factor. Is 18" wide panel acceptable for this project?	The 18" width for Petersen Aluminum's T-250 panel is acceptable for this project.
Would a product substitution from MBCI for the metal panels be acceptable?	MBCI does not have an equivalent panel configuration to what is specified, the "T" type panel that allows easier removal for maintenance purposes, so we cannot consider this manufacturer as an equivalent product substitution.
Is attendance at the pre-proposal conference mandatory?	Pre-proposal meeting attendance is not mandatory – however it is strongly encouraged that contractors schedule a site visit to review the roofs after confirming they meet the project qualifications and schedule requirements. The pre-proposal meeting powerpoint slides are available on the district website for reference.

ADDENDUM NO. 1 Page 1 of 2


PROJECT MANUAL

Div	Section	Item	Revision
07	076100	2.1.B.1	Add the following clarification regarding panel width:
			"(18" width permitted where 24" is not available)"

DRAWINGS

Sheet	Revision
R1.01	Replace with the attached REVISED "R1.01" - Corrected scope hatch at A01 roof area - Corrected canopy area labels, missing one canopy in hatch for scope - Corrected roof system panel description to allow for 18" width - Clarified wording on scope of work slightly
R2.00	Replace with the attached REVISED "R2.00" - Corrected canopy area label - Deleted gutter at A01 over NIC built up roof area
R2.01	Replace with the attached REVISED "R2.01" - Corrected canopy area labels
R2.02	Replace with the attached REVISED "R2.02" -Corrected canopy area label -Added "OPEN" to NIC open areas
R2.04	Replace with the attached REVISED "R2.04" - Added note clarifying wall areas over NIC roofs are not included scope
R2.05	Replace with the attached REVISED "R2.05" - Clarified Alt. Bid wall panel work at existing louvers
R3.00	 Replace with the attached REVISED "R3.00" - Detail 1, Gutter: Minor text clarifications, deleted requirement to coat gutter straps - Detail 2, Rake Detail: revised to reflect field conditions and match fascia replacement indicated at gutter detail - Detail 3, Rake at High Eave: revised notes to match components drawn - Detail 4, Ridge: revised 24" width to 18" for added layer of underlayment to match ridge details at other sheets
R3.01	Replace with the attached REVISED "R3.01" - Detail 1, Gutter: Minor text clarifications, deleted requirement to coat gutter straps - Detail 4, Ridge: clarified note for added layer of underlayment
R3.03	Replace with the attached REVISED "R3.03" - Detail 1, Gutter: Minor text clarifications, deleted requirement to coat gutter straps - Detail 4, Ridge: clarified note for added layer of underlayment - Detail 5, Alt. Bid – Rake to Wall Detail: revised trim at new wall panels - Detail 6, Alt. Bid – New Panels at Existing: revised termination of underlayment at trim to seal edge prior to trim installation

END OF ADDENDUM NO. 1

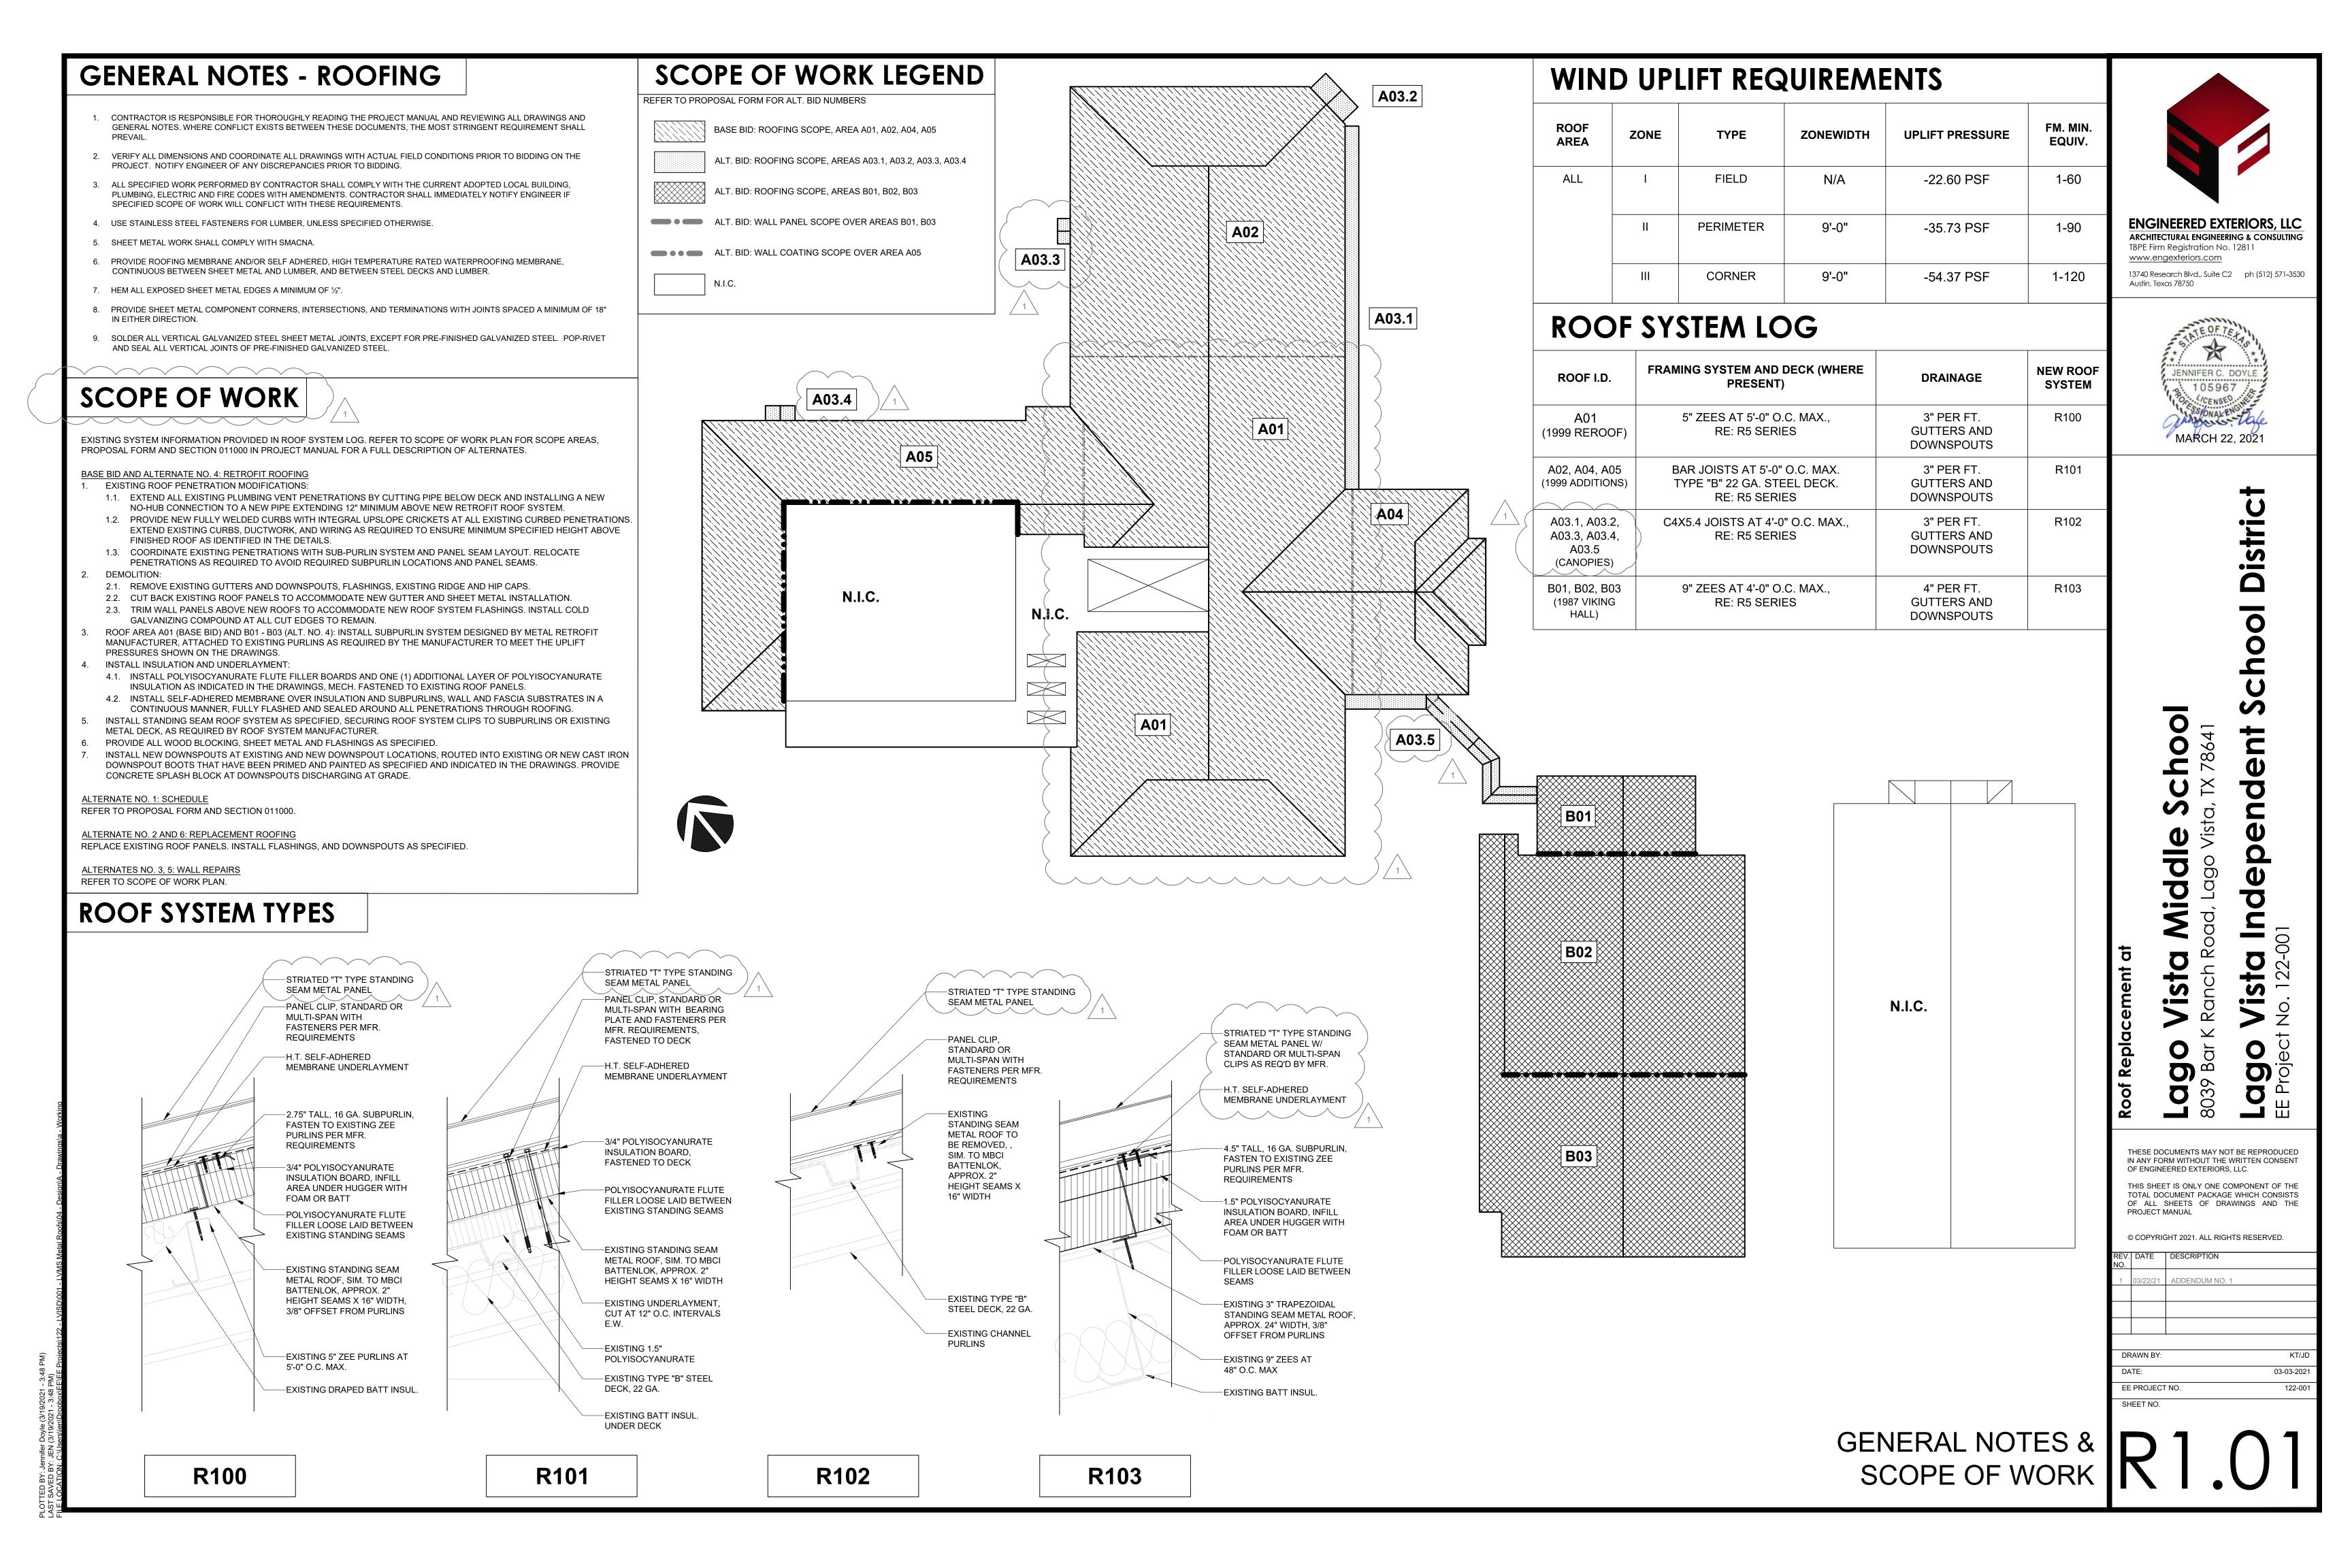



TYPICAL ROOF PENETRATIONS ARE SHOWN AS REFERENCED IN THE DRAWINGS BY SECTION CUTS. IT IS INTENDED THAT CONDITIONS SIMILAR TO THOSE SHOWN IN DETAIL ARE TO BE TREATED IN A SIMILAR MANNER.

LOCATION AND QUANTITY OF ROOF OBJECTS, PENETRATIONS AND EQUIPMENT ARE FOR REFERENCE ONLY. CONTRACTOR IS RESPONSIBLE FOR FIELD VERIFYING DIMENSIONS, QUANTITIES, AND LOCATIONS PRIOR TO BIDDING.

LEGEND



ROOF AREA I.D.



SLOPE OF EXISTING ROOF OR

SLOPE OF NEW INSULATION

ELEVATION CHANGE +X.XX INSULATION THICKNESS

WALL BENEATH ROOF **EXPANSION JOINT**

PARAPET WALL **GUTTER AND DOWNSPOUT** SC OFSC PRIMARY AND OVERFLOW

COLLECTOR HEAD

SPLASH BLOCK AND SPLASH PAN

— E — ELEC. CONDUIT

——CD—— CONDENSATE DRAIN PIPE — G — GAS PIPING

---- R ---- REFRIG. PIPING _____ LIGHTNING PROTECTION

ROOFTOP UNIT PIPE SUPPORT

PIPE/CONDUIT PENETRATION CURB


PIPE PENETRATION THROUGH ROOF FLUE STACK ON CURB


GOOSENECK ON CURB

GRAVITY EXHAUST VENT ON CURB POWERED EXHAUST VENT ON CURB

ABANDONED PENETRATION

SMOKE HATCH

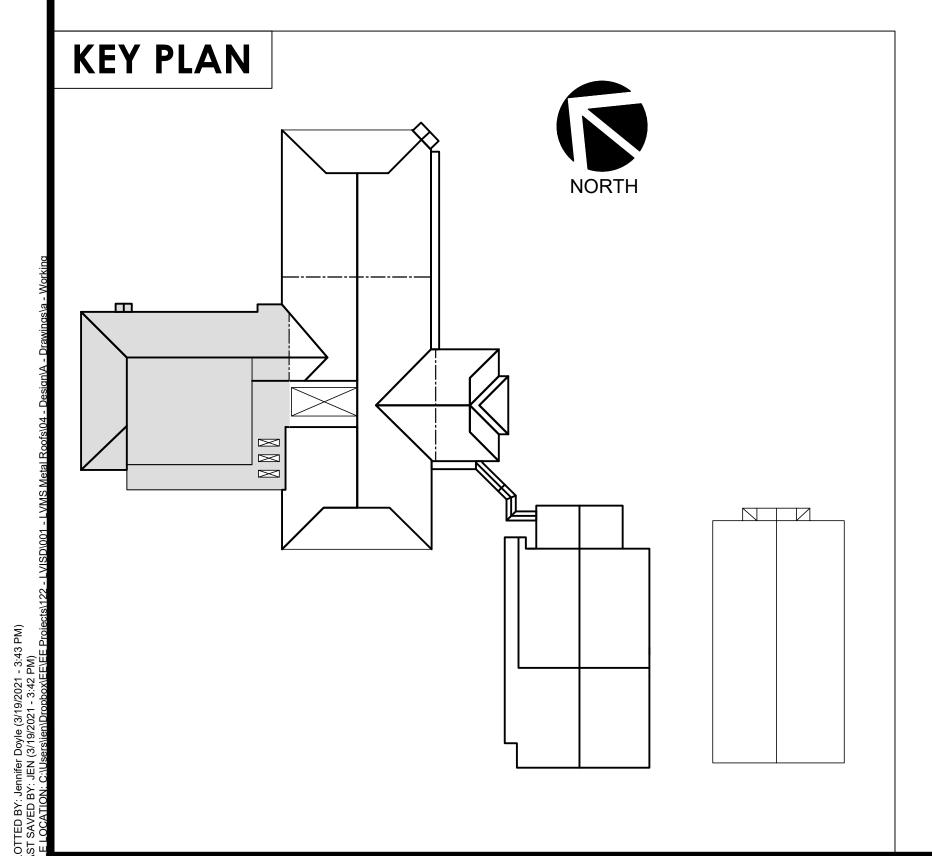


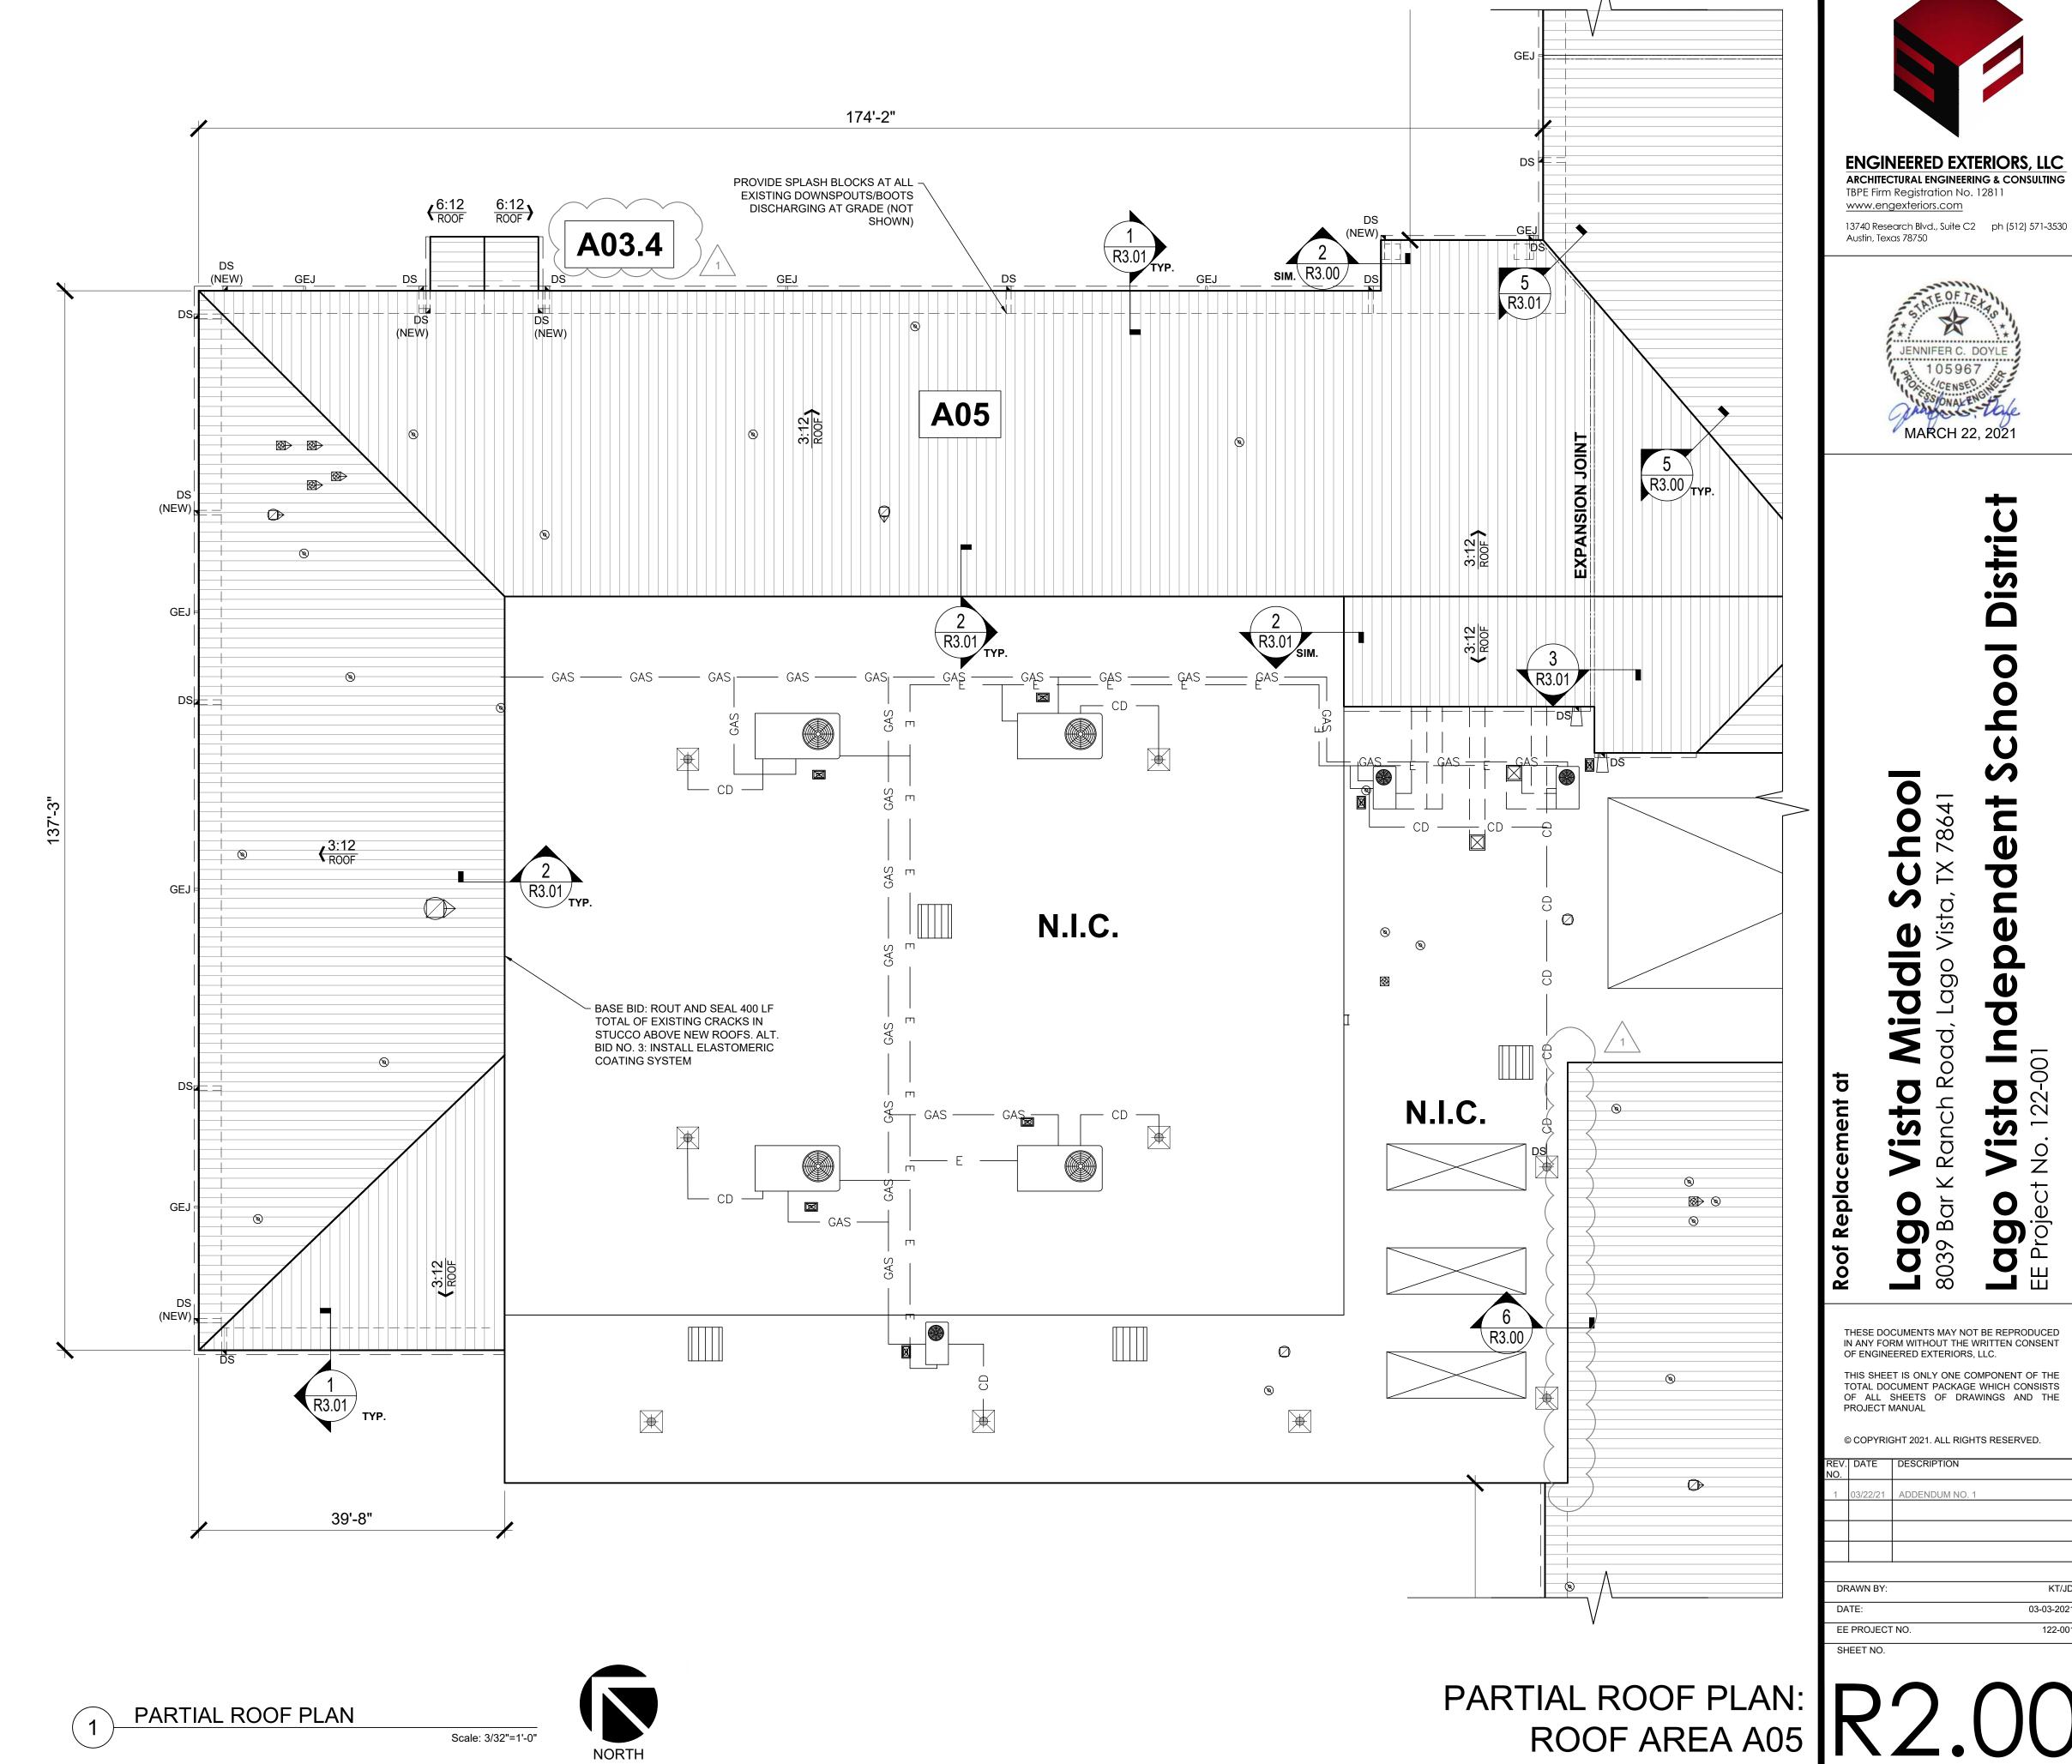



Scale: 3/32"=1'-0"

JENNIFER C. DOYLE 105967


MARCH 22, 2021

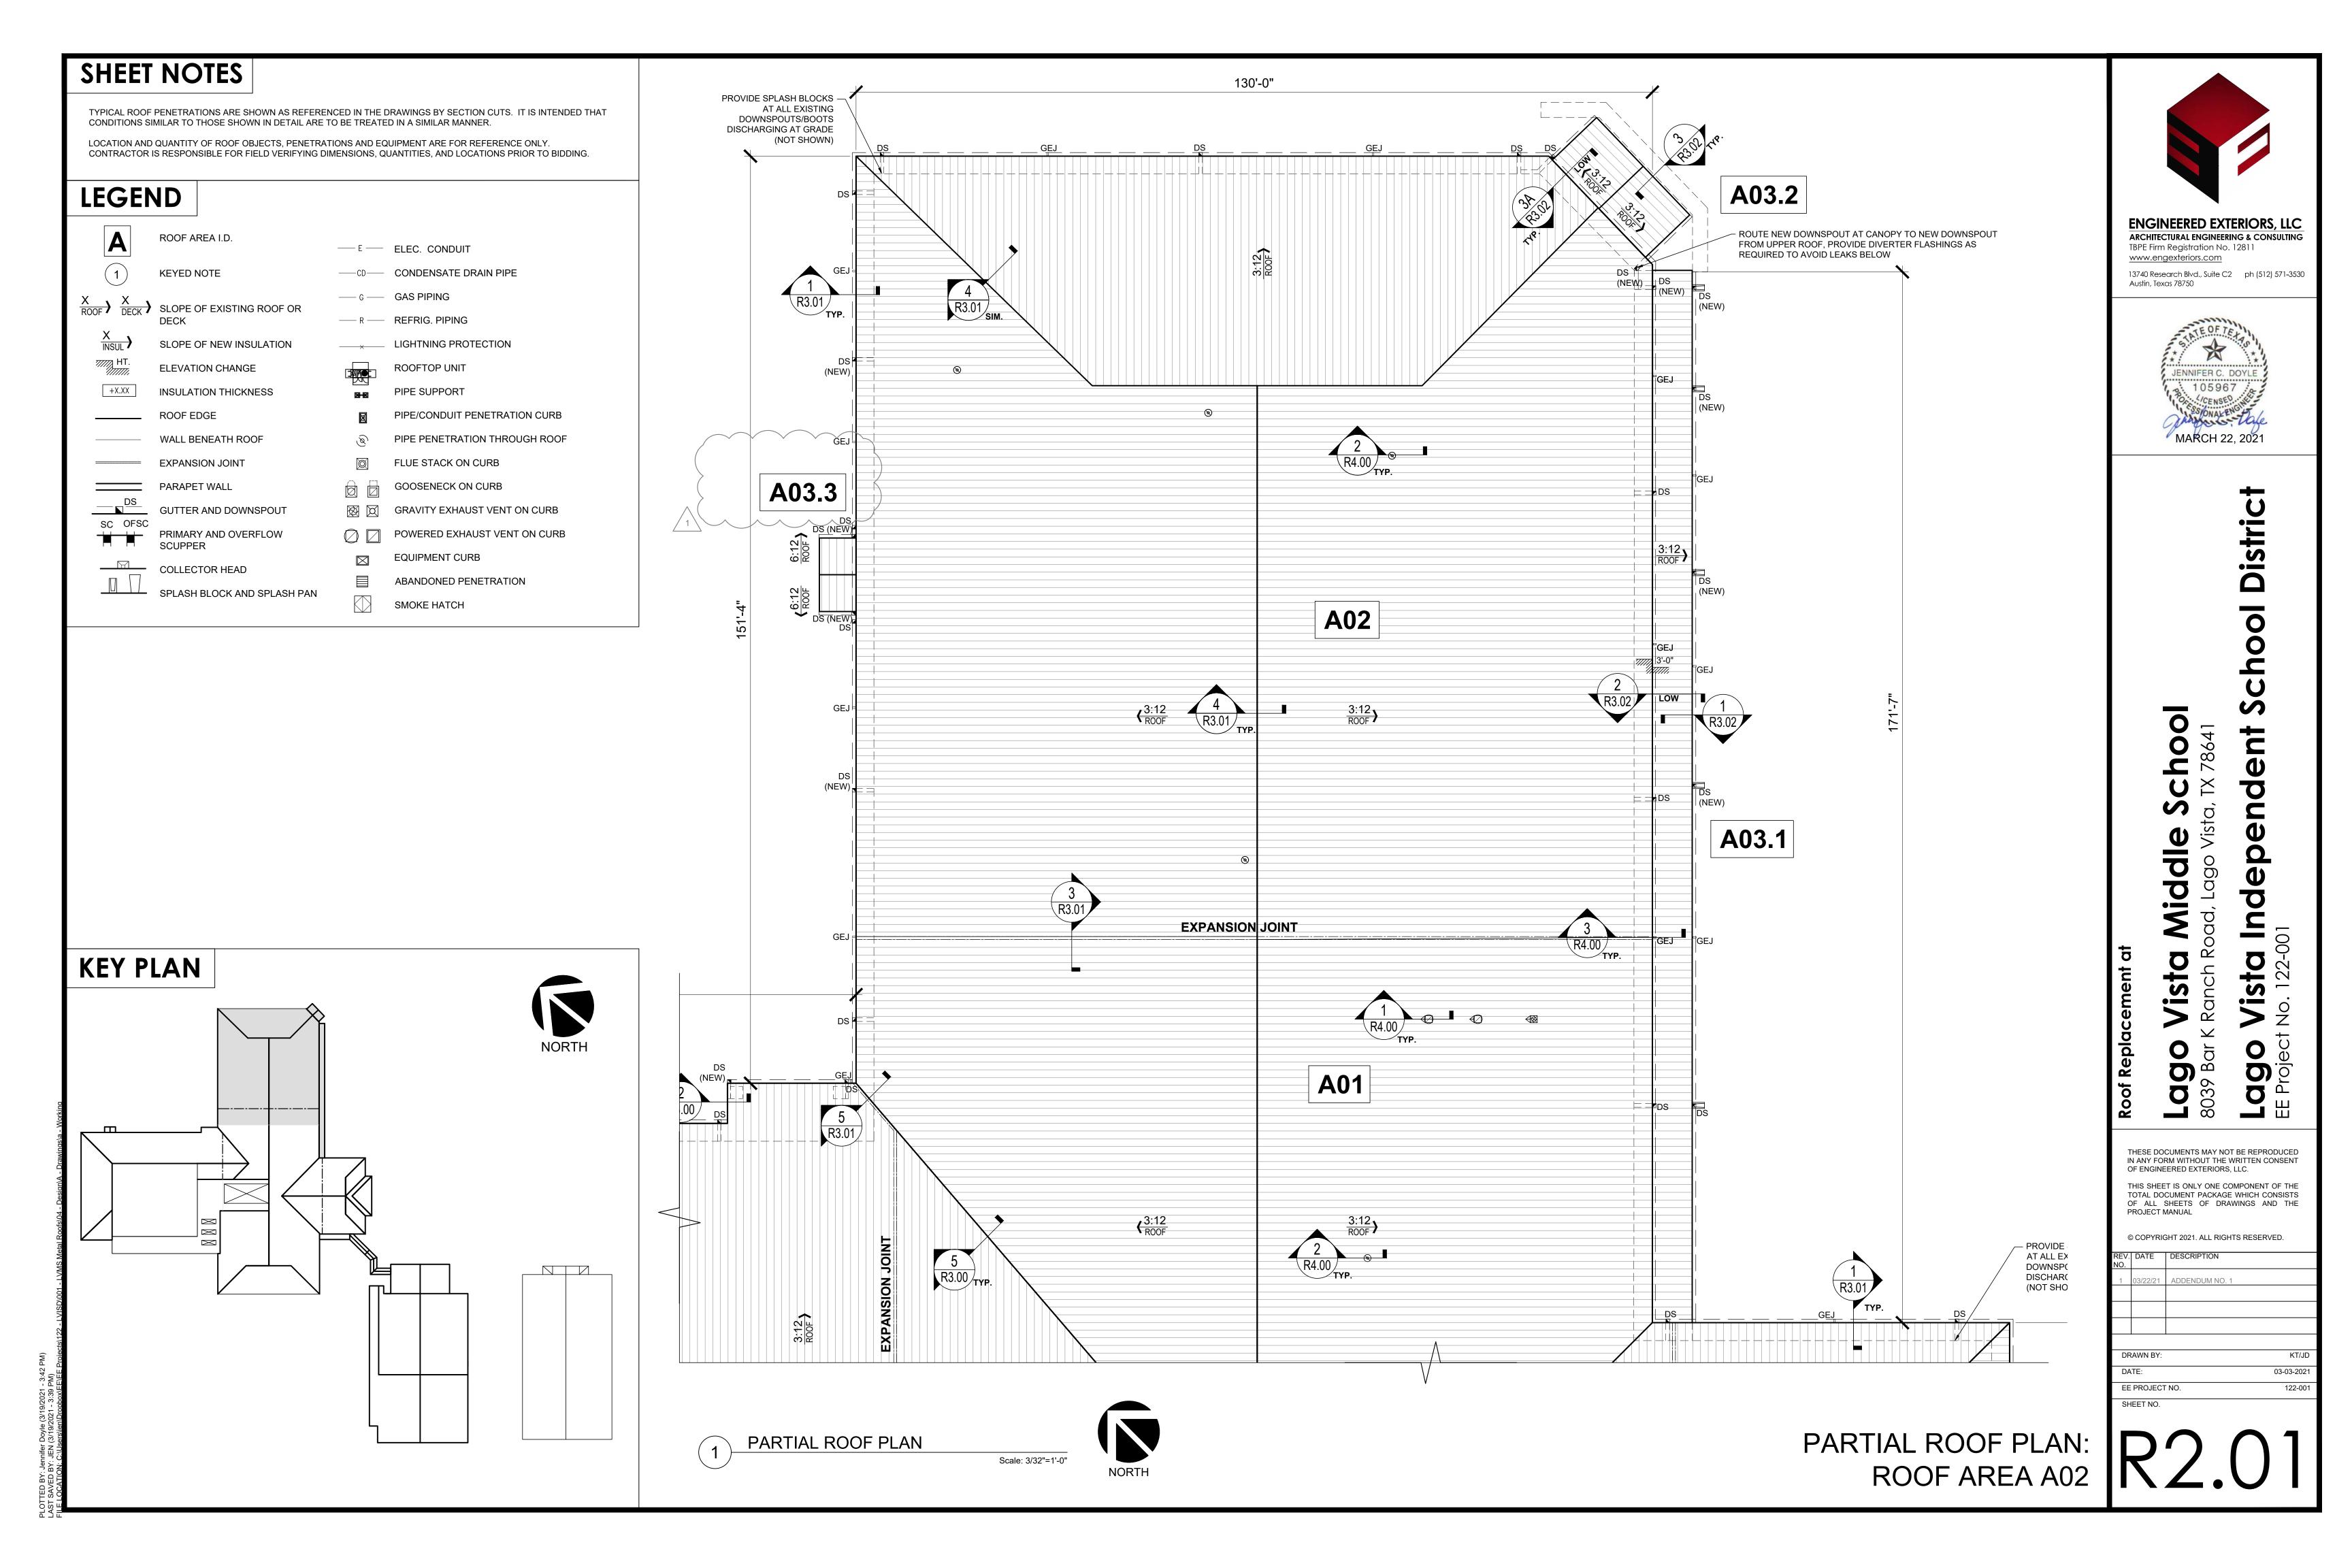

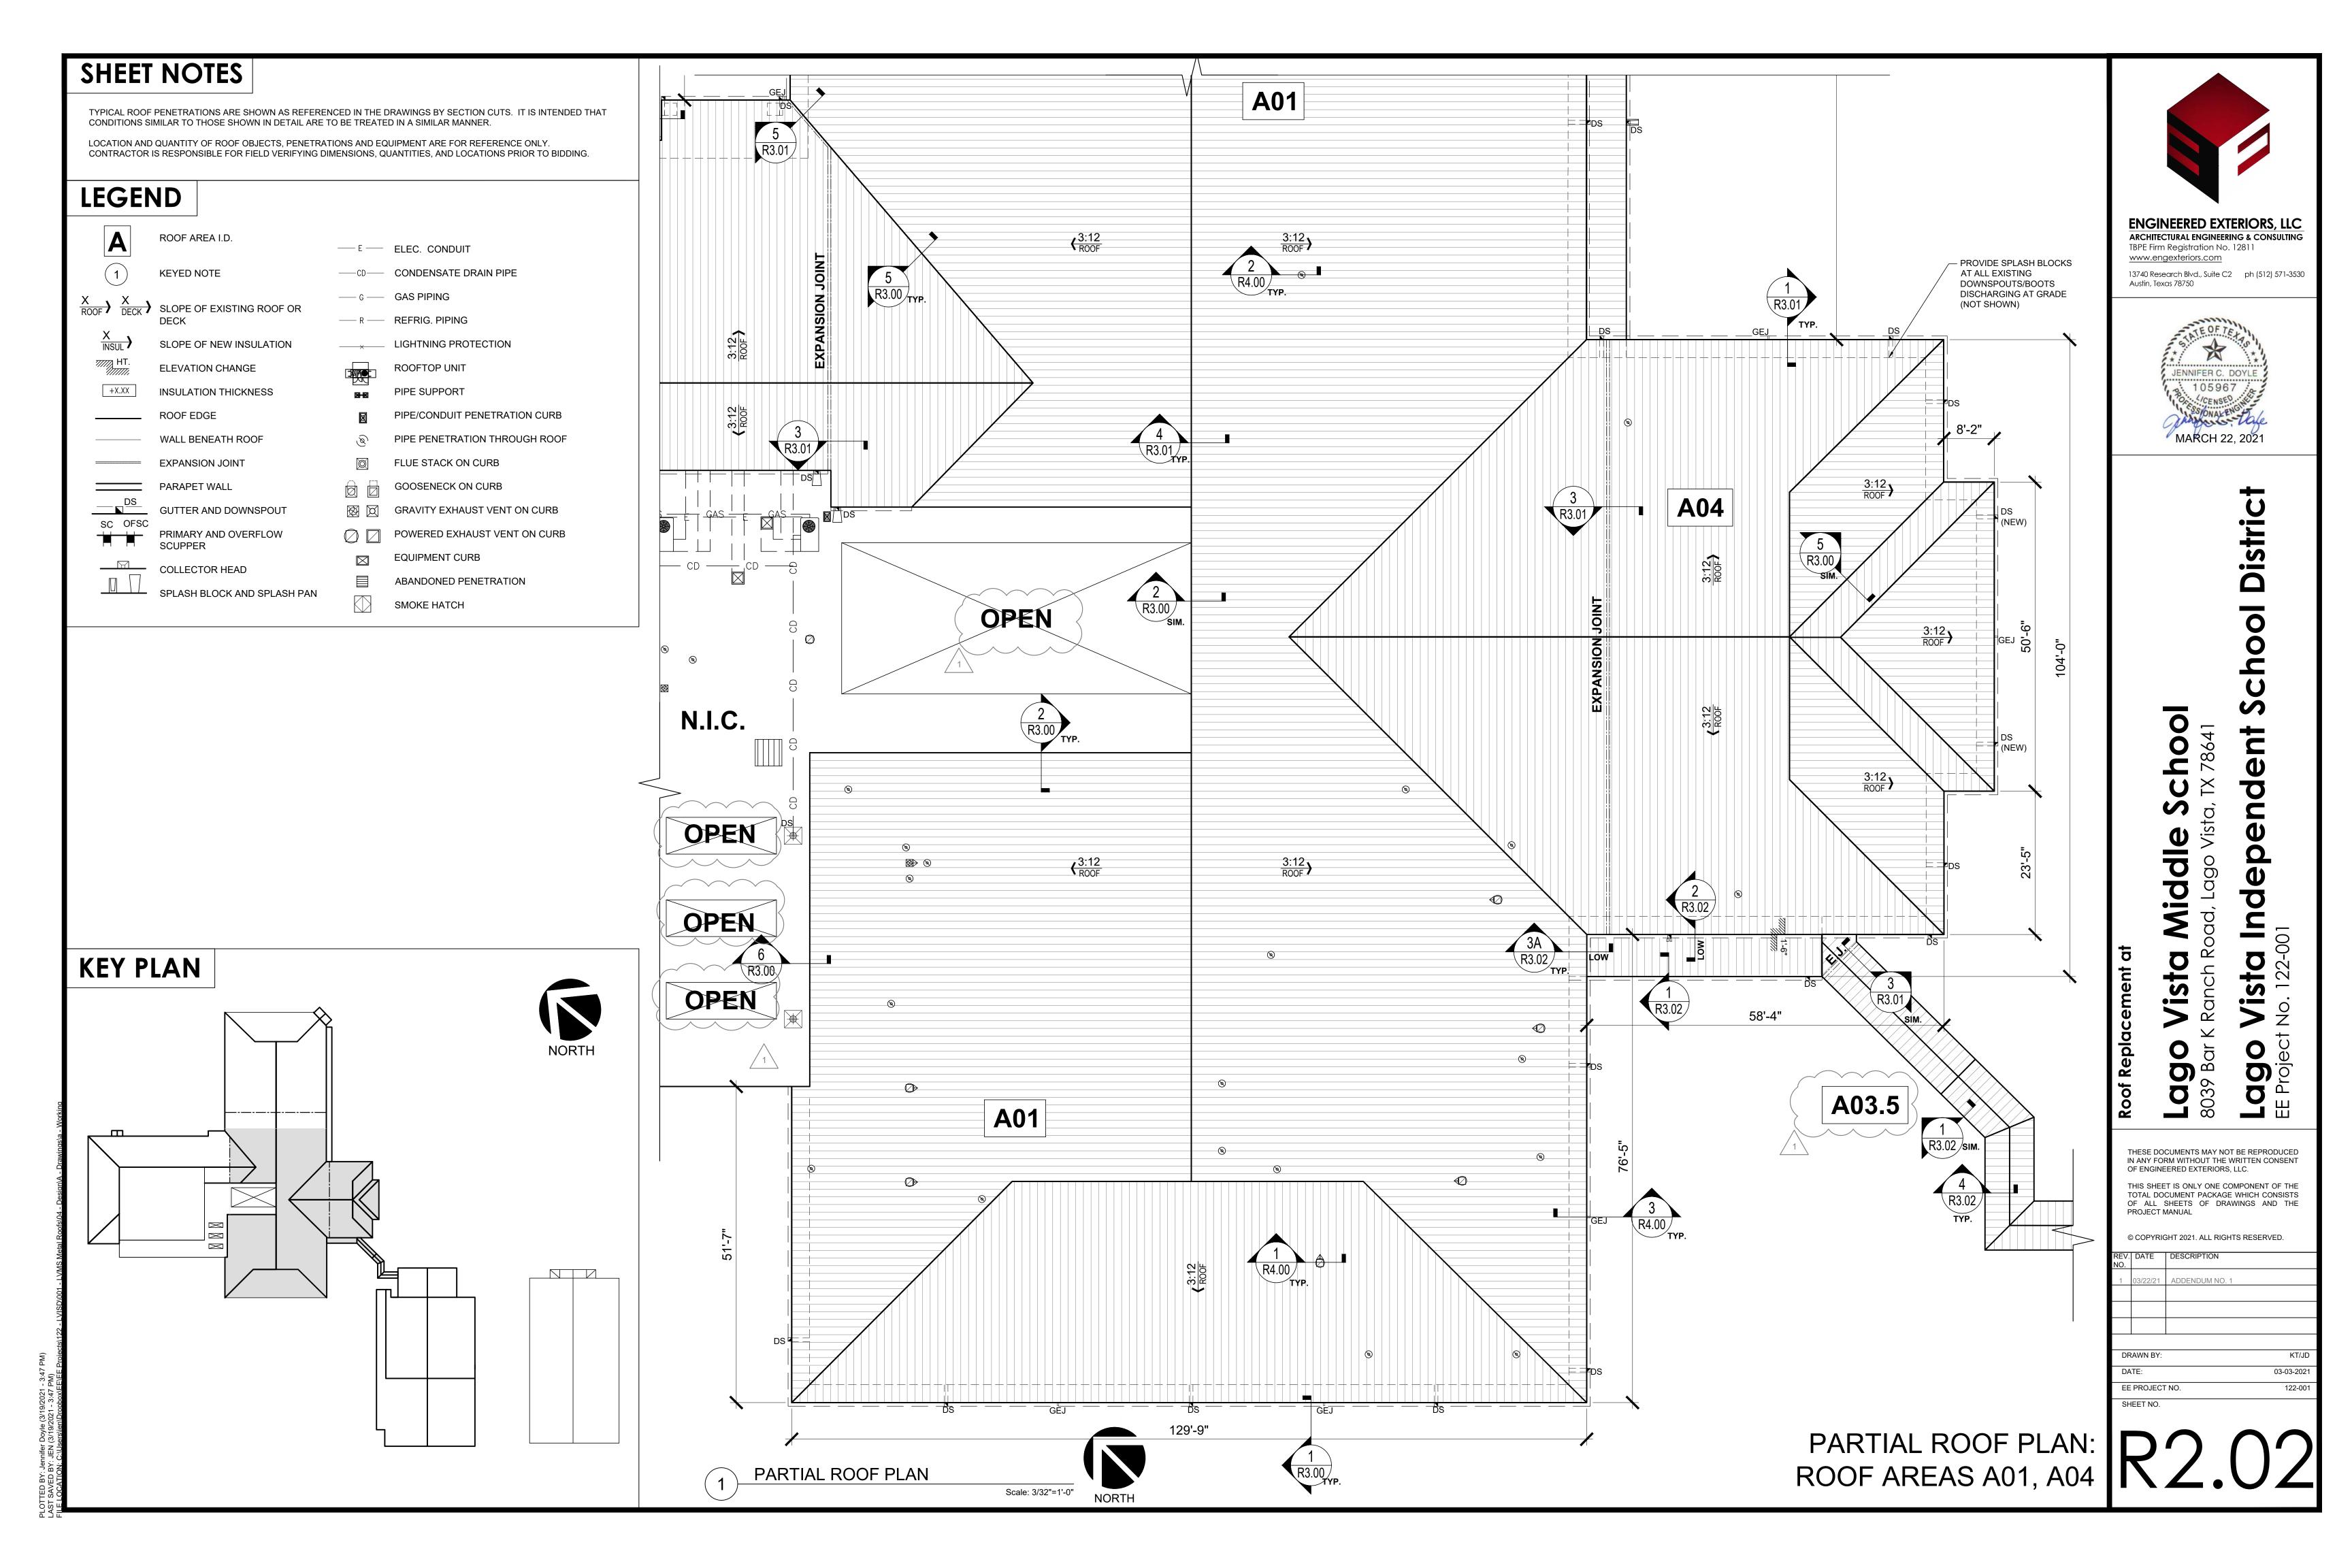

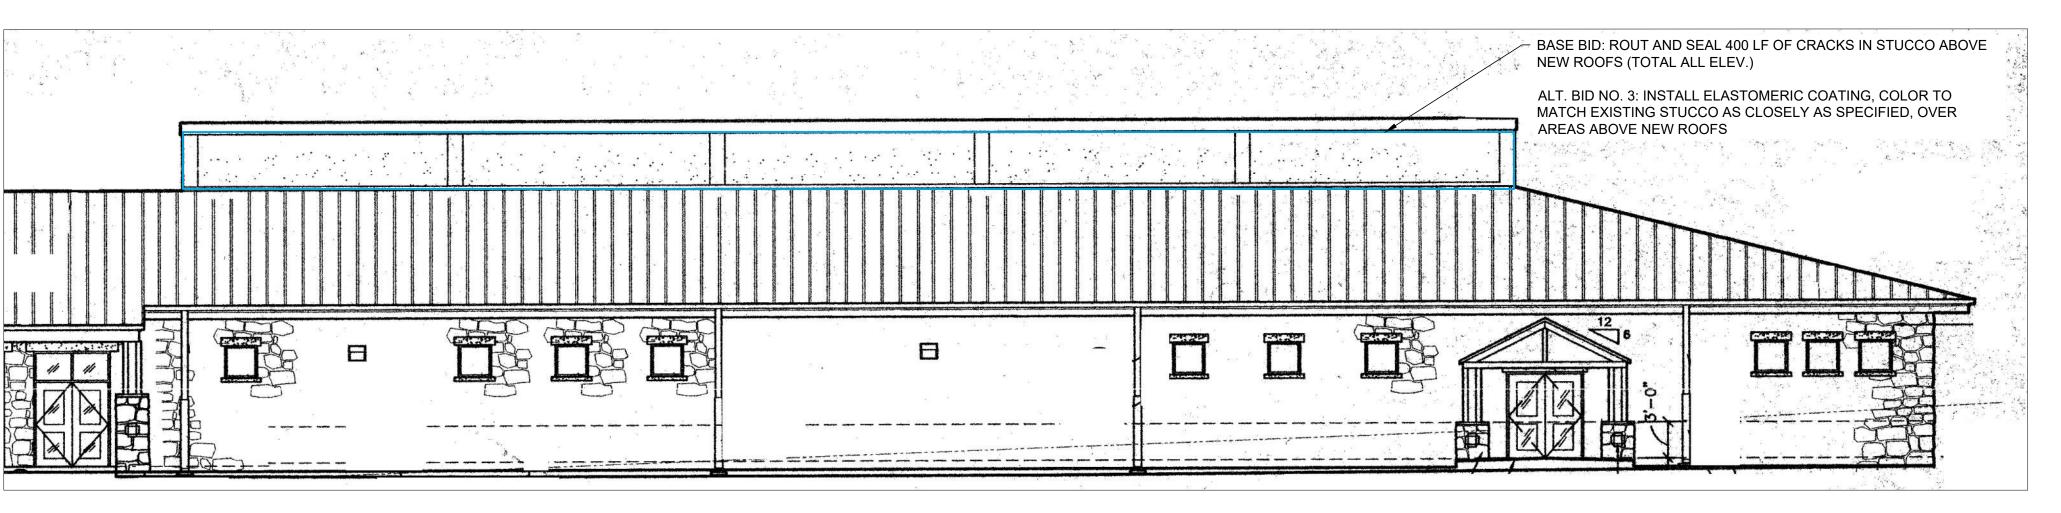


AS BUILT ELEVATION: ROOF A05 - EAST Scale: APPROX. 1/8"=1'-0"

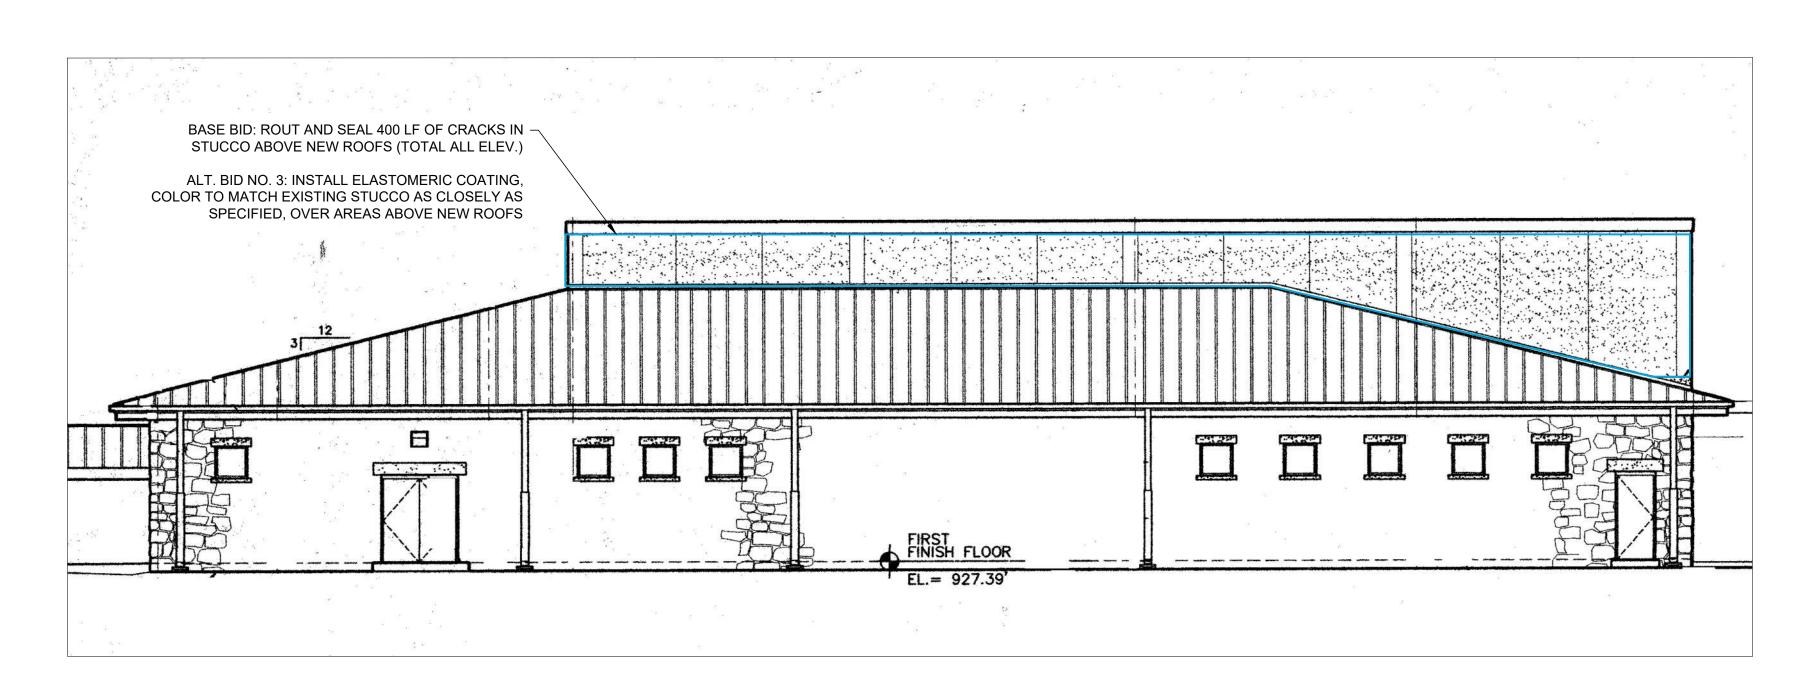

SHEET NOTES

TYPICAL ROOF PENETRATIONS ARE SHOWN AS REFERENCED IN THE DRAWINGS BY SECTION CUTS. IT IS INTENDED THAT CONDITIONS SIMILAR TO THOSE SHOWN IN DETAIL ARE TO BE TREATED IN A SIMILAR MANNER.

LOCATION AND QUANTITY OF ROOF OBJECTS, PENETRATIONS AND EQUIPMENT ARE FOR REFERENCE ONLY. CONTRACTOR IS RESPONSIBLE FOR FIELD VERIFYING DIMENSIONS, QUANTITIES, AND LOCATIONS PRIOR TO BIDDING.

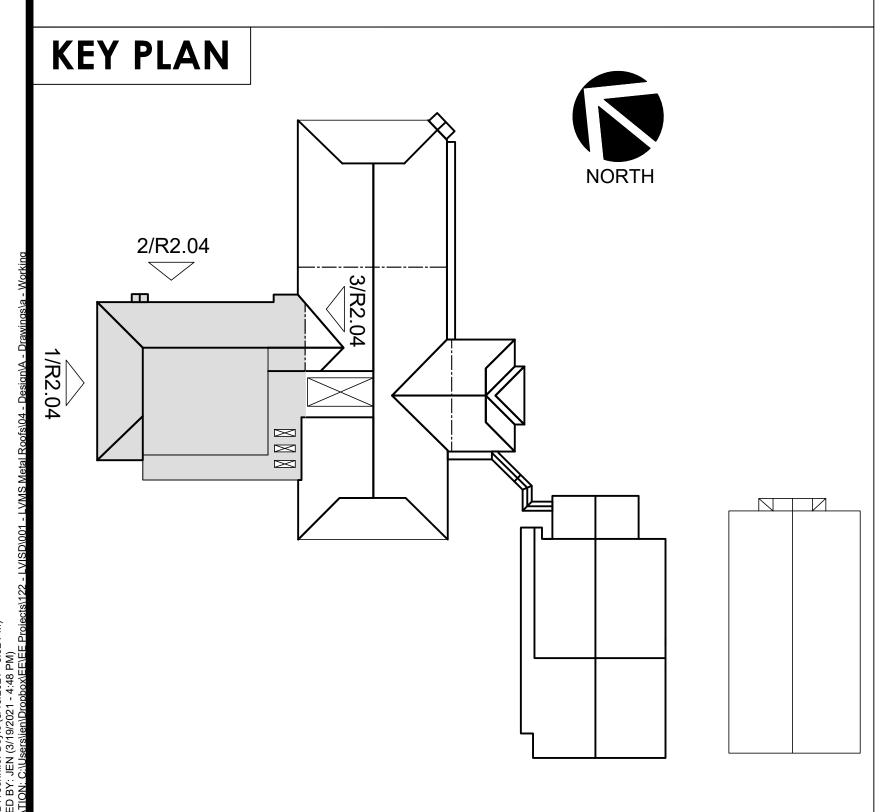

AS BUILT ELEVATION: ROOF A05 - NORTH Scale: APPROX. 1/8"=1'-0"

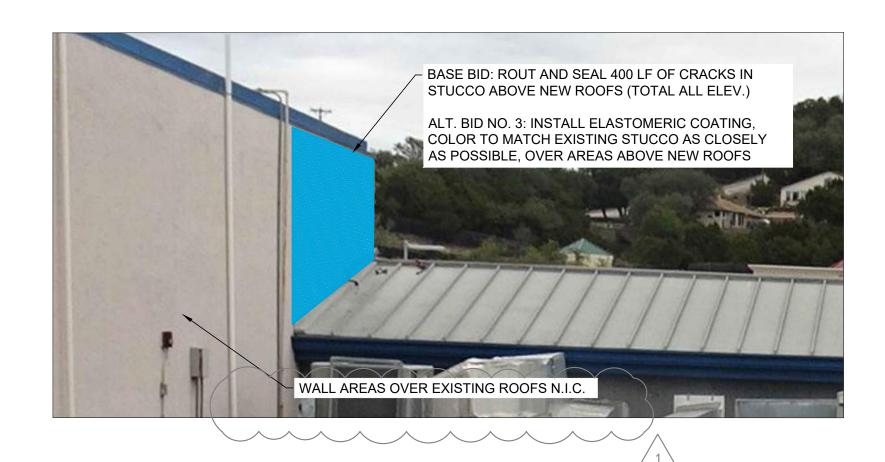


PHOTO ELEVATION: ROOF A05 - SOUTH

AS BUILT ELEVATIONS: ROOF AREA A05 ROOF






THESE DOCUMENTS MAY NOT BE REPRODUCED IN ANY FORM WITHOUT THE WRITTEN CONSENT OF ENGINEERED EXTERIORS, LLC. THIS SHEET IS ONLY ONE COMPONENT OF THE

TOTAL DOCUMENT PACKAGE WHICH CONSISTS OF ALL SHEETS OF DRAWINGS AND THE PROJECT MANUAL

© COPYRIGHT 2021. ALL RIGHTS RESERVED. REV. DATE DESCRIPTION

NO.		
1	03/22/21	ADDENDUM NO. 1
DRAWN BY:		KT/JD
DA	TE:	03-03-2021
EE	PROJECT	NO. 122-001

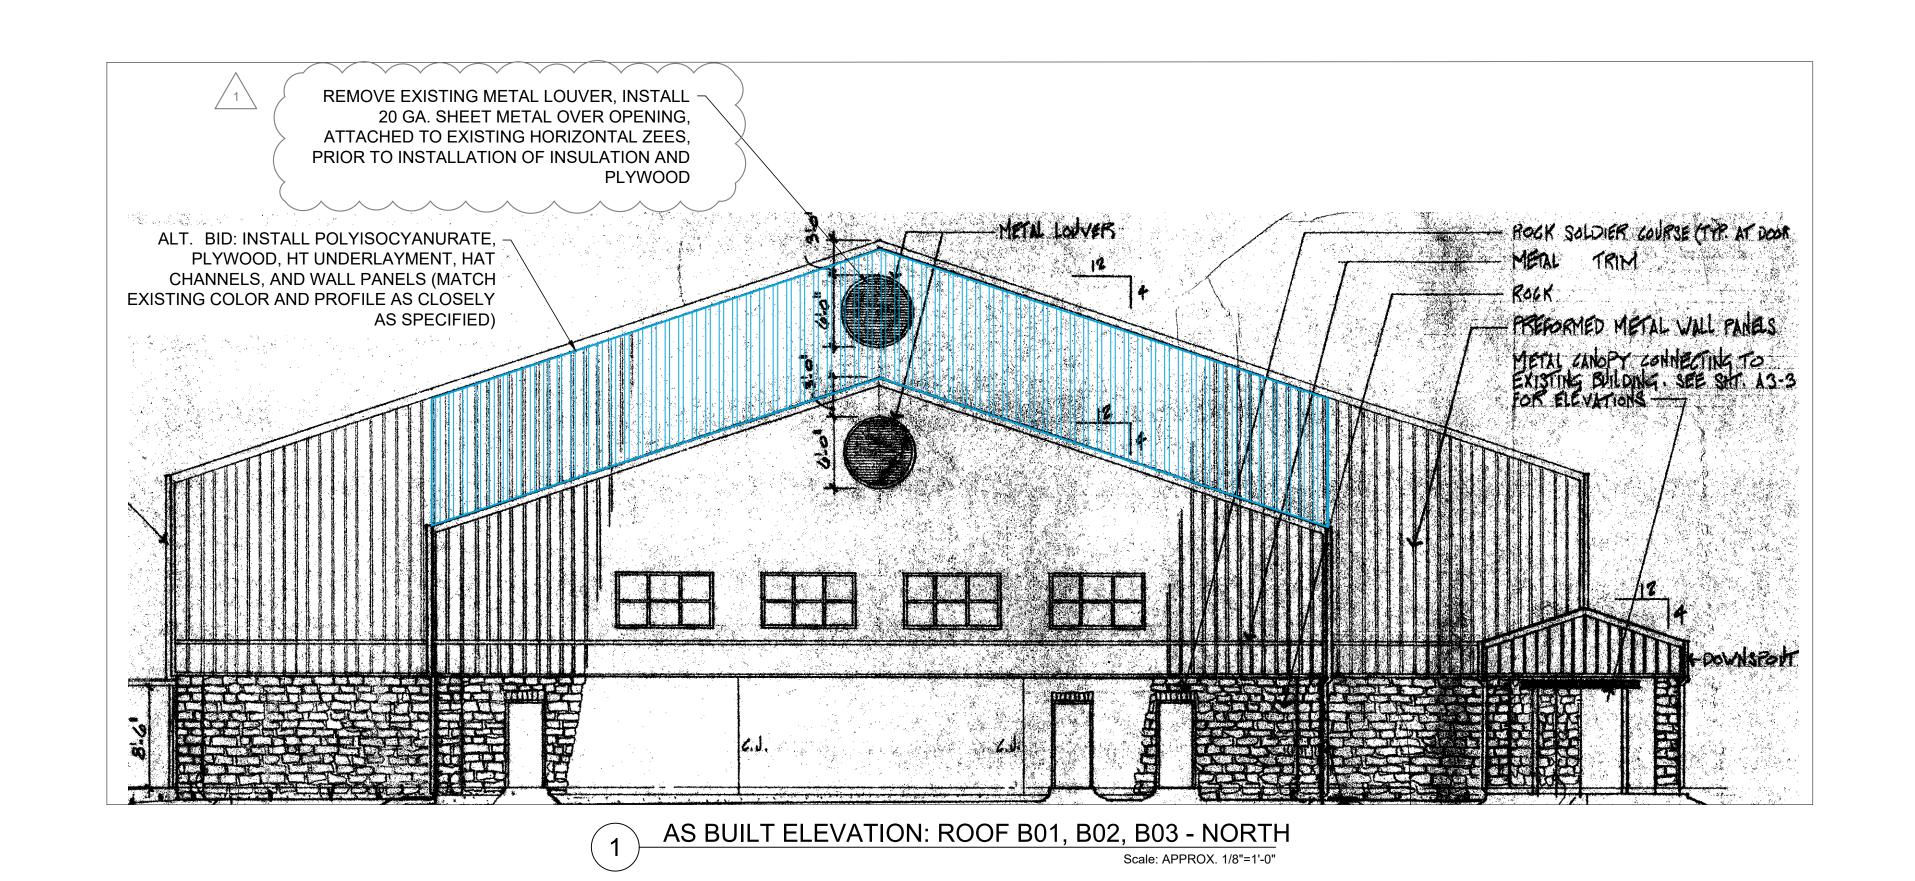

SHEET NOTES


TYPICAL ROOF PENETRATIONS ARE SHOWN AS REFERENCED IN THE DRAWINGS BY SECTION CUTS. IT IS INTENDED THAT CONDITIONS SIMILAR TO THOSE SHOWN IN DETAIL ARE TO BE TREATED IN A SIMILAR MANNER.

LOCATION AND QUANTITY OF ROOF OBJECTS, PENETRATIONS AND EQUIPMENT ARE FOR REFERENCE ONLY. CONTRACTOR IS RESPONSIBLE FOR FIELD VERIFYING DIMENSIONS, QUANTITIES, AND LOCATIONS PRIOR TO BIDDING.

KEY PLAN


NORTH

2/R2.04

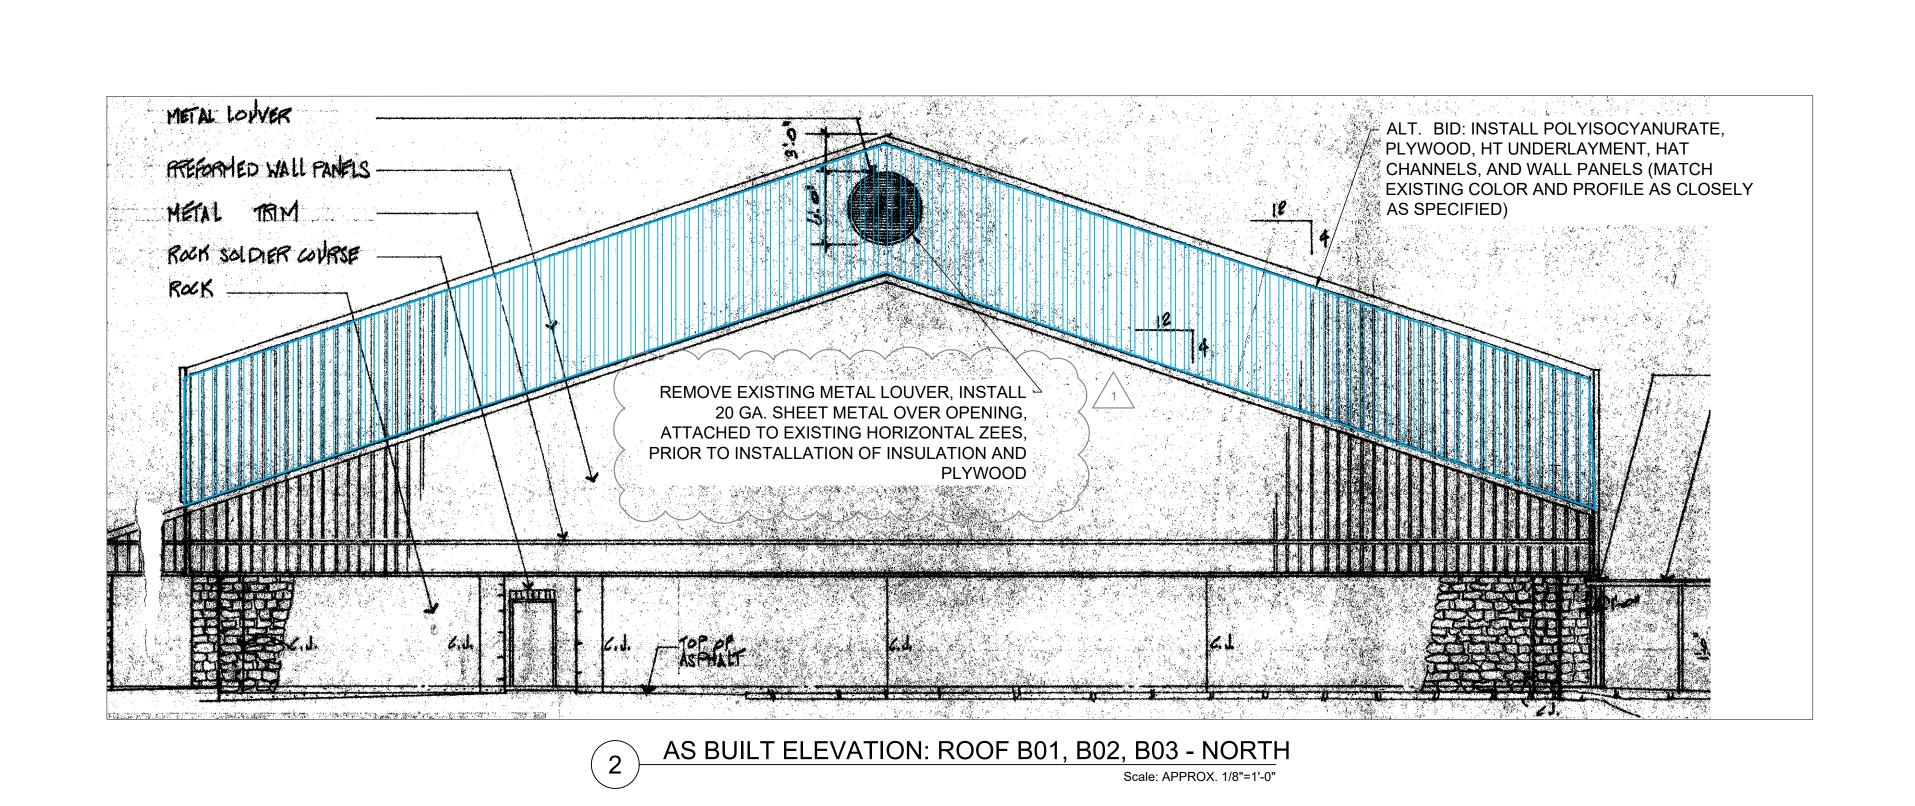

ENGINEERED EXTERIORS, LLC ARCHITECTURAL ENGINEERING & CONSULTING TBPE Firm Registration No. 12811 www.engexteriors.com 13740 Research Blvd., Suite C2 ph (512) 571-3530 **District** S THESE DOCUMENTS MAY NOT BE REPRODUCED IN ANY FORM WITHOUT THE WRITTEN CONSENT OF ENGINEERED EXTERIORS, LLC. THIS SHEET IS ONLY ONE COMPONENT OF THE TOTAL DOCUMENT PACKAGE WHICH CONSISTS OF ALL SHEETS OF DRAWINGS AND THE © COPYRIGHT 2021. ALL RIGHTS RESERVED. EV. DATE DESCRIPTION EE PROJECT NO.

AS-BUILT ELEVATIONS: ROOF AREAS B01, B02, B03 ROOF

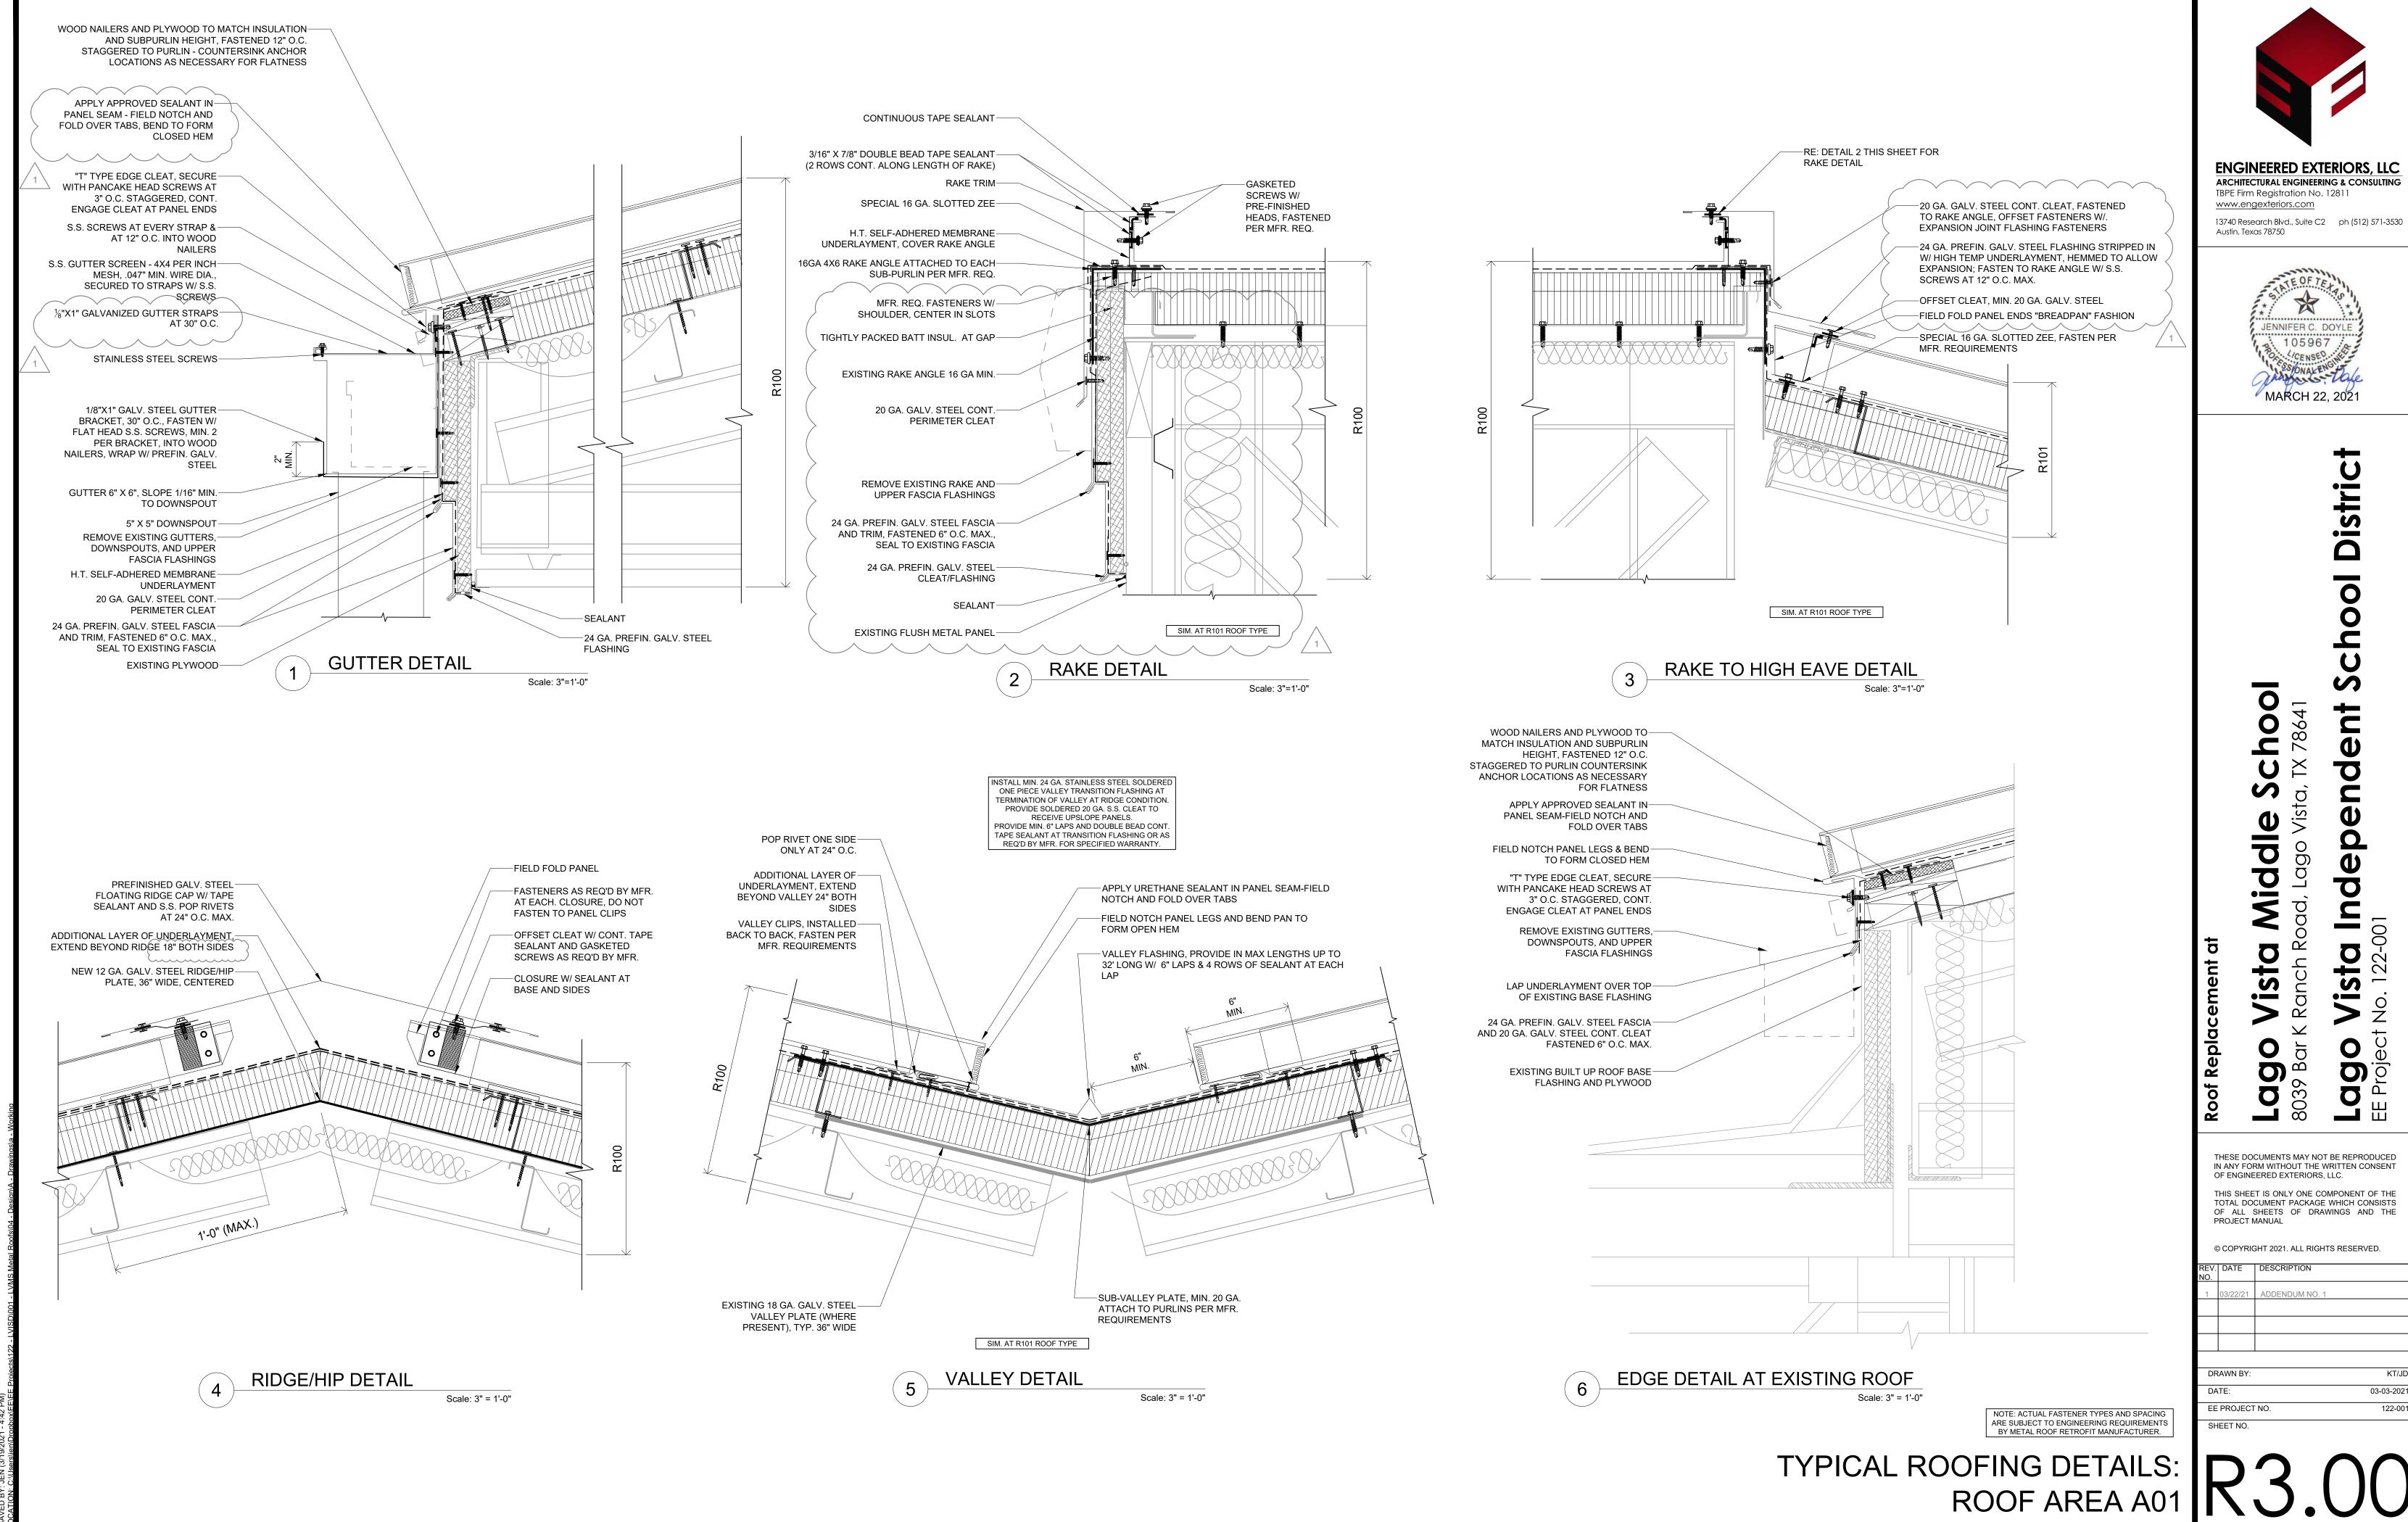

ENGINEERED EXTERIORS, LLC ARCHITECTURAL ENGINEERING & CONSULTING TBPE Firm Registration No. 12811



stri


Middle D

S •

THESE DOCUMENTS MAY NOT BE REPRODUCED IN ANY FORM WITHOUT THE WRITTEN CONSENT OF ENGINEERED EXTERIORS, LLC. THIS SHEET IS ONLY ONE COMPONENT OF THE TOTAL DOCUMENT PACKAGE WHICH CONSISTS
OF ALL SHEETS OF DRAWINGS AND THE

© COPYRIGHT 2021. ALL RIGHTS RESERVED.

ADDENDUM NO. 1 DRAWN BY 03-03-2021 EE PROJECT NO. 122-001

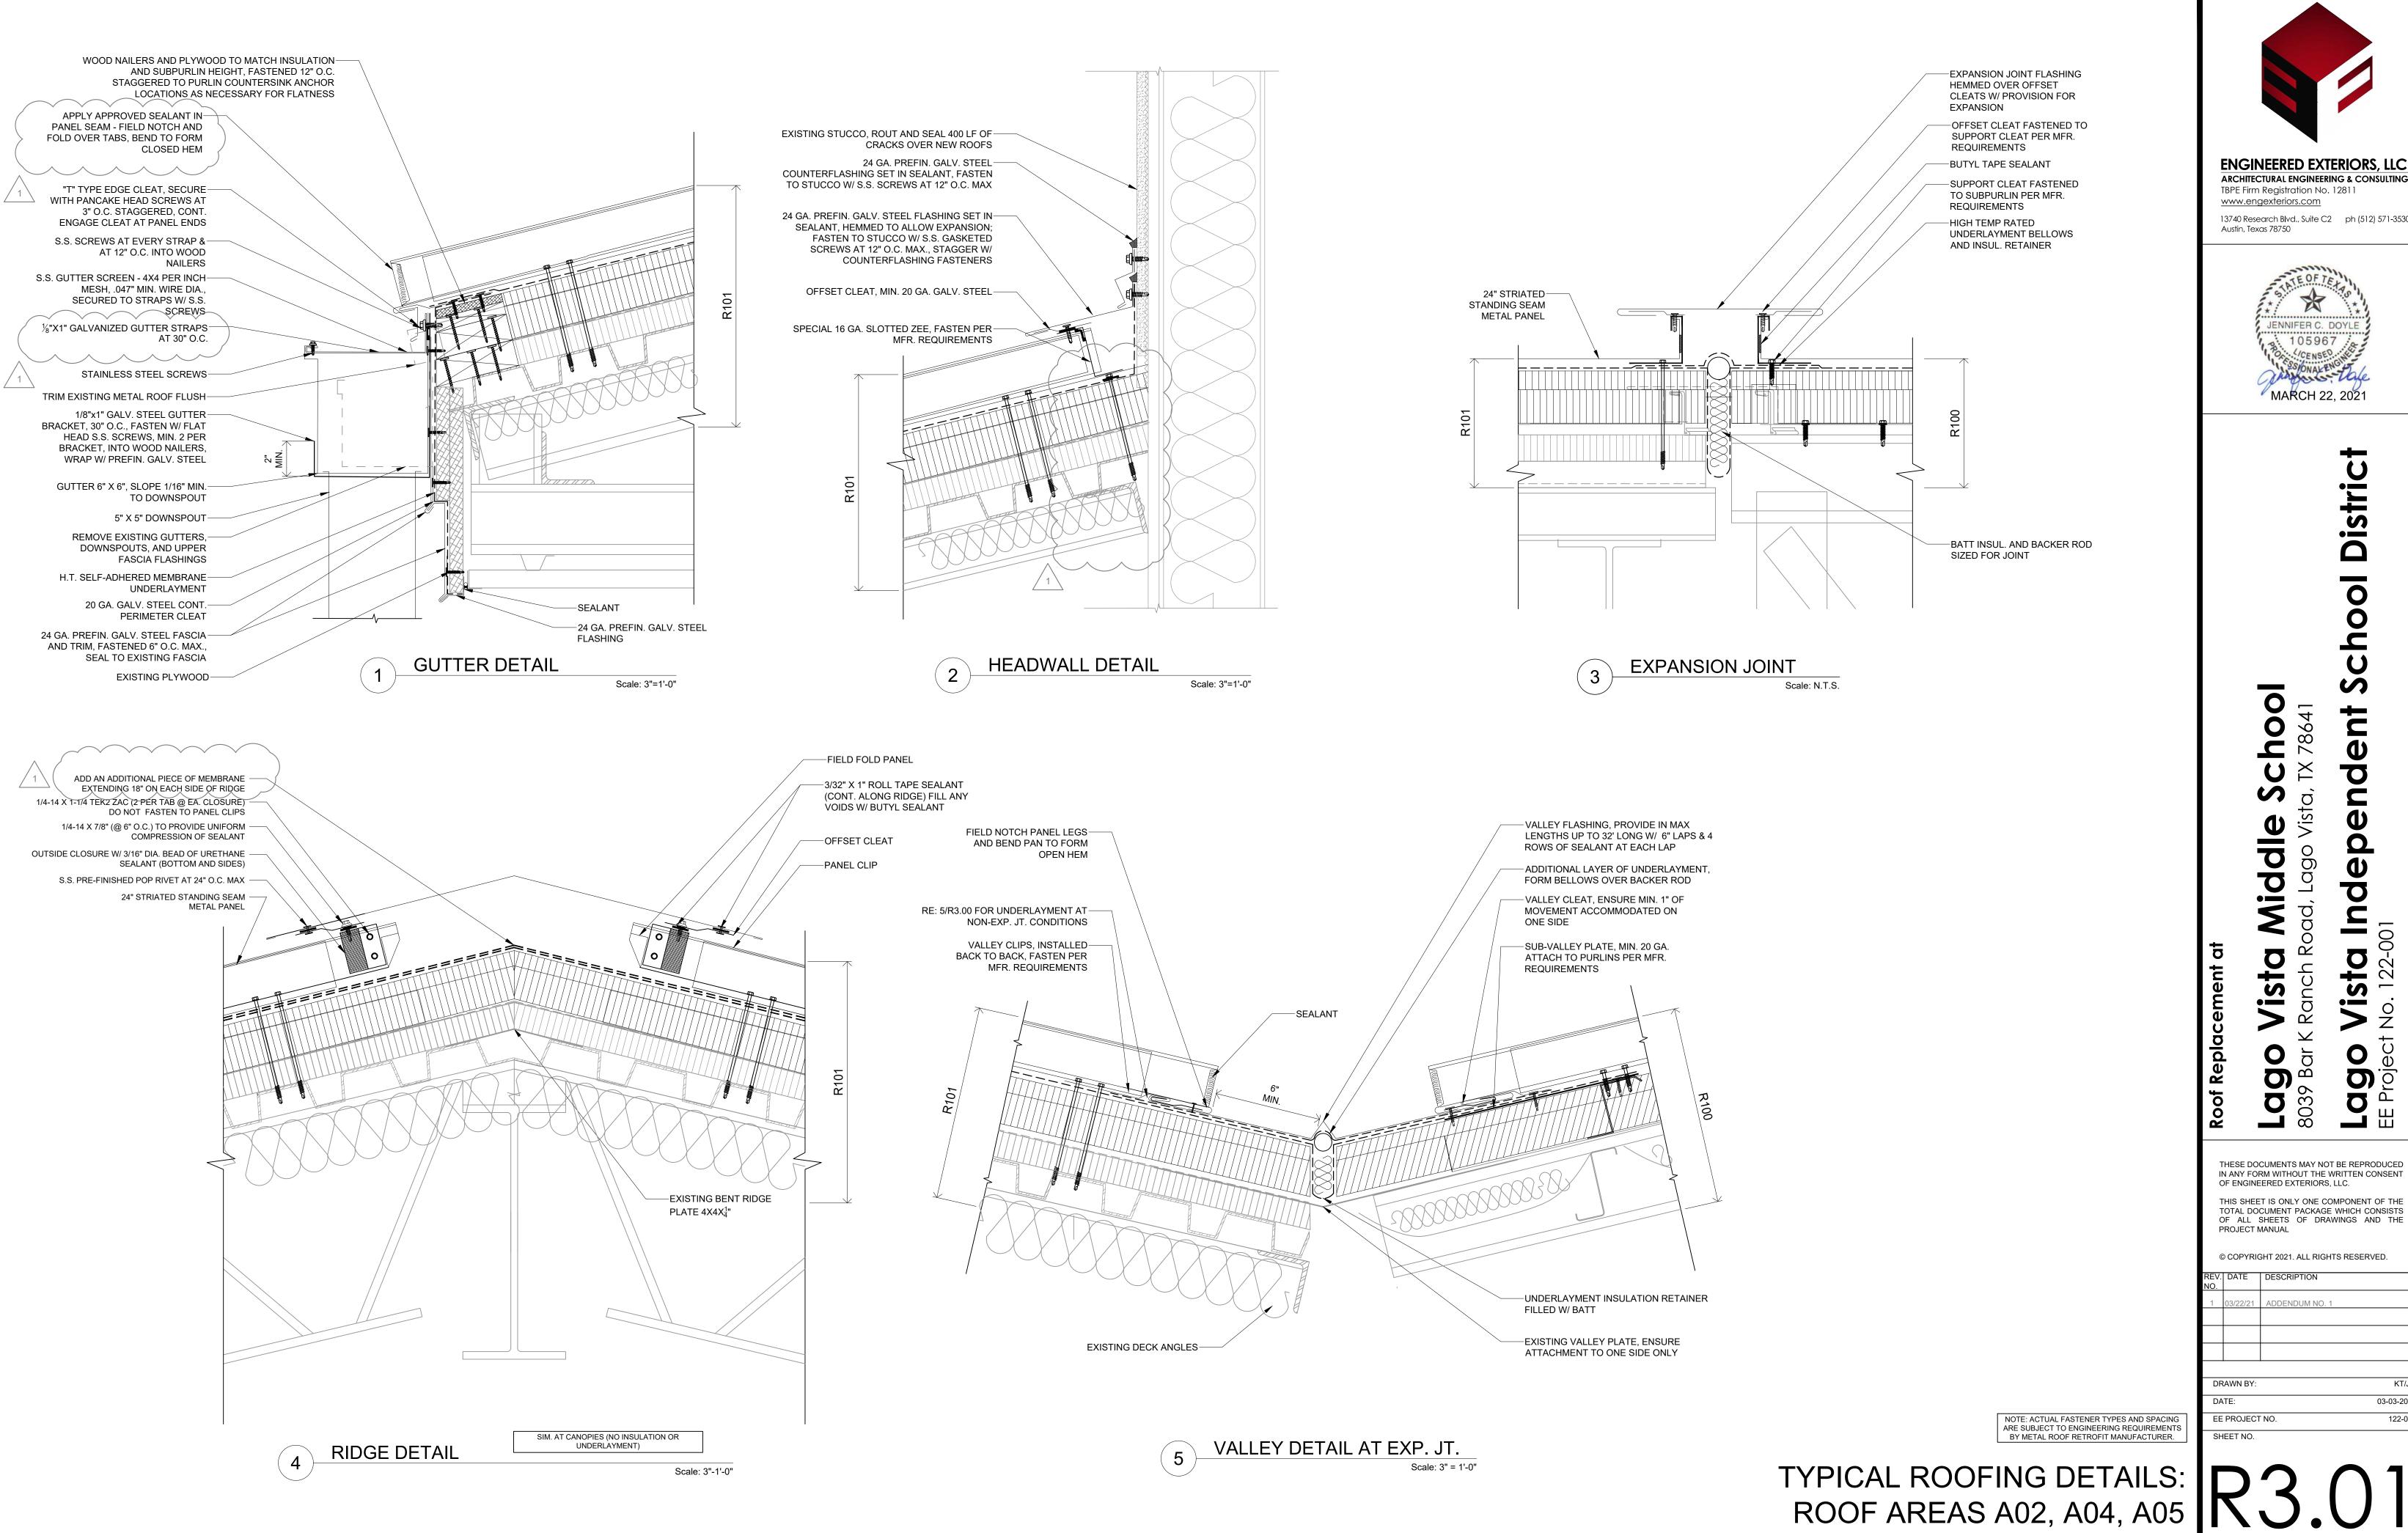




www.engexteriors.com 13740 Research Blvd., Suite C2 ph (512) 571-3530



THESE DOCUMENTS MAY NOT BE REPRODUCED IN ANY FORM WITHOUT THE WRITTEN CONSENT OF ENGINEERED EXTERIORS, LLC. THIS SHEET IS ONLY ONE COMPONENT OF THE

© COPYRIGHT 2021. ALL RIGHTS RESERVED.

03-03-2021

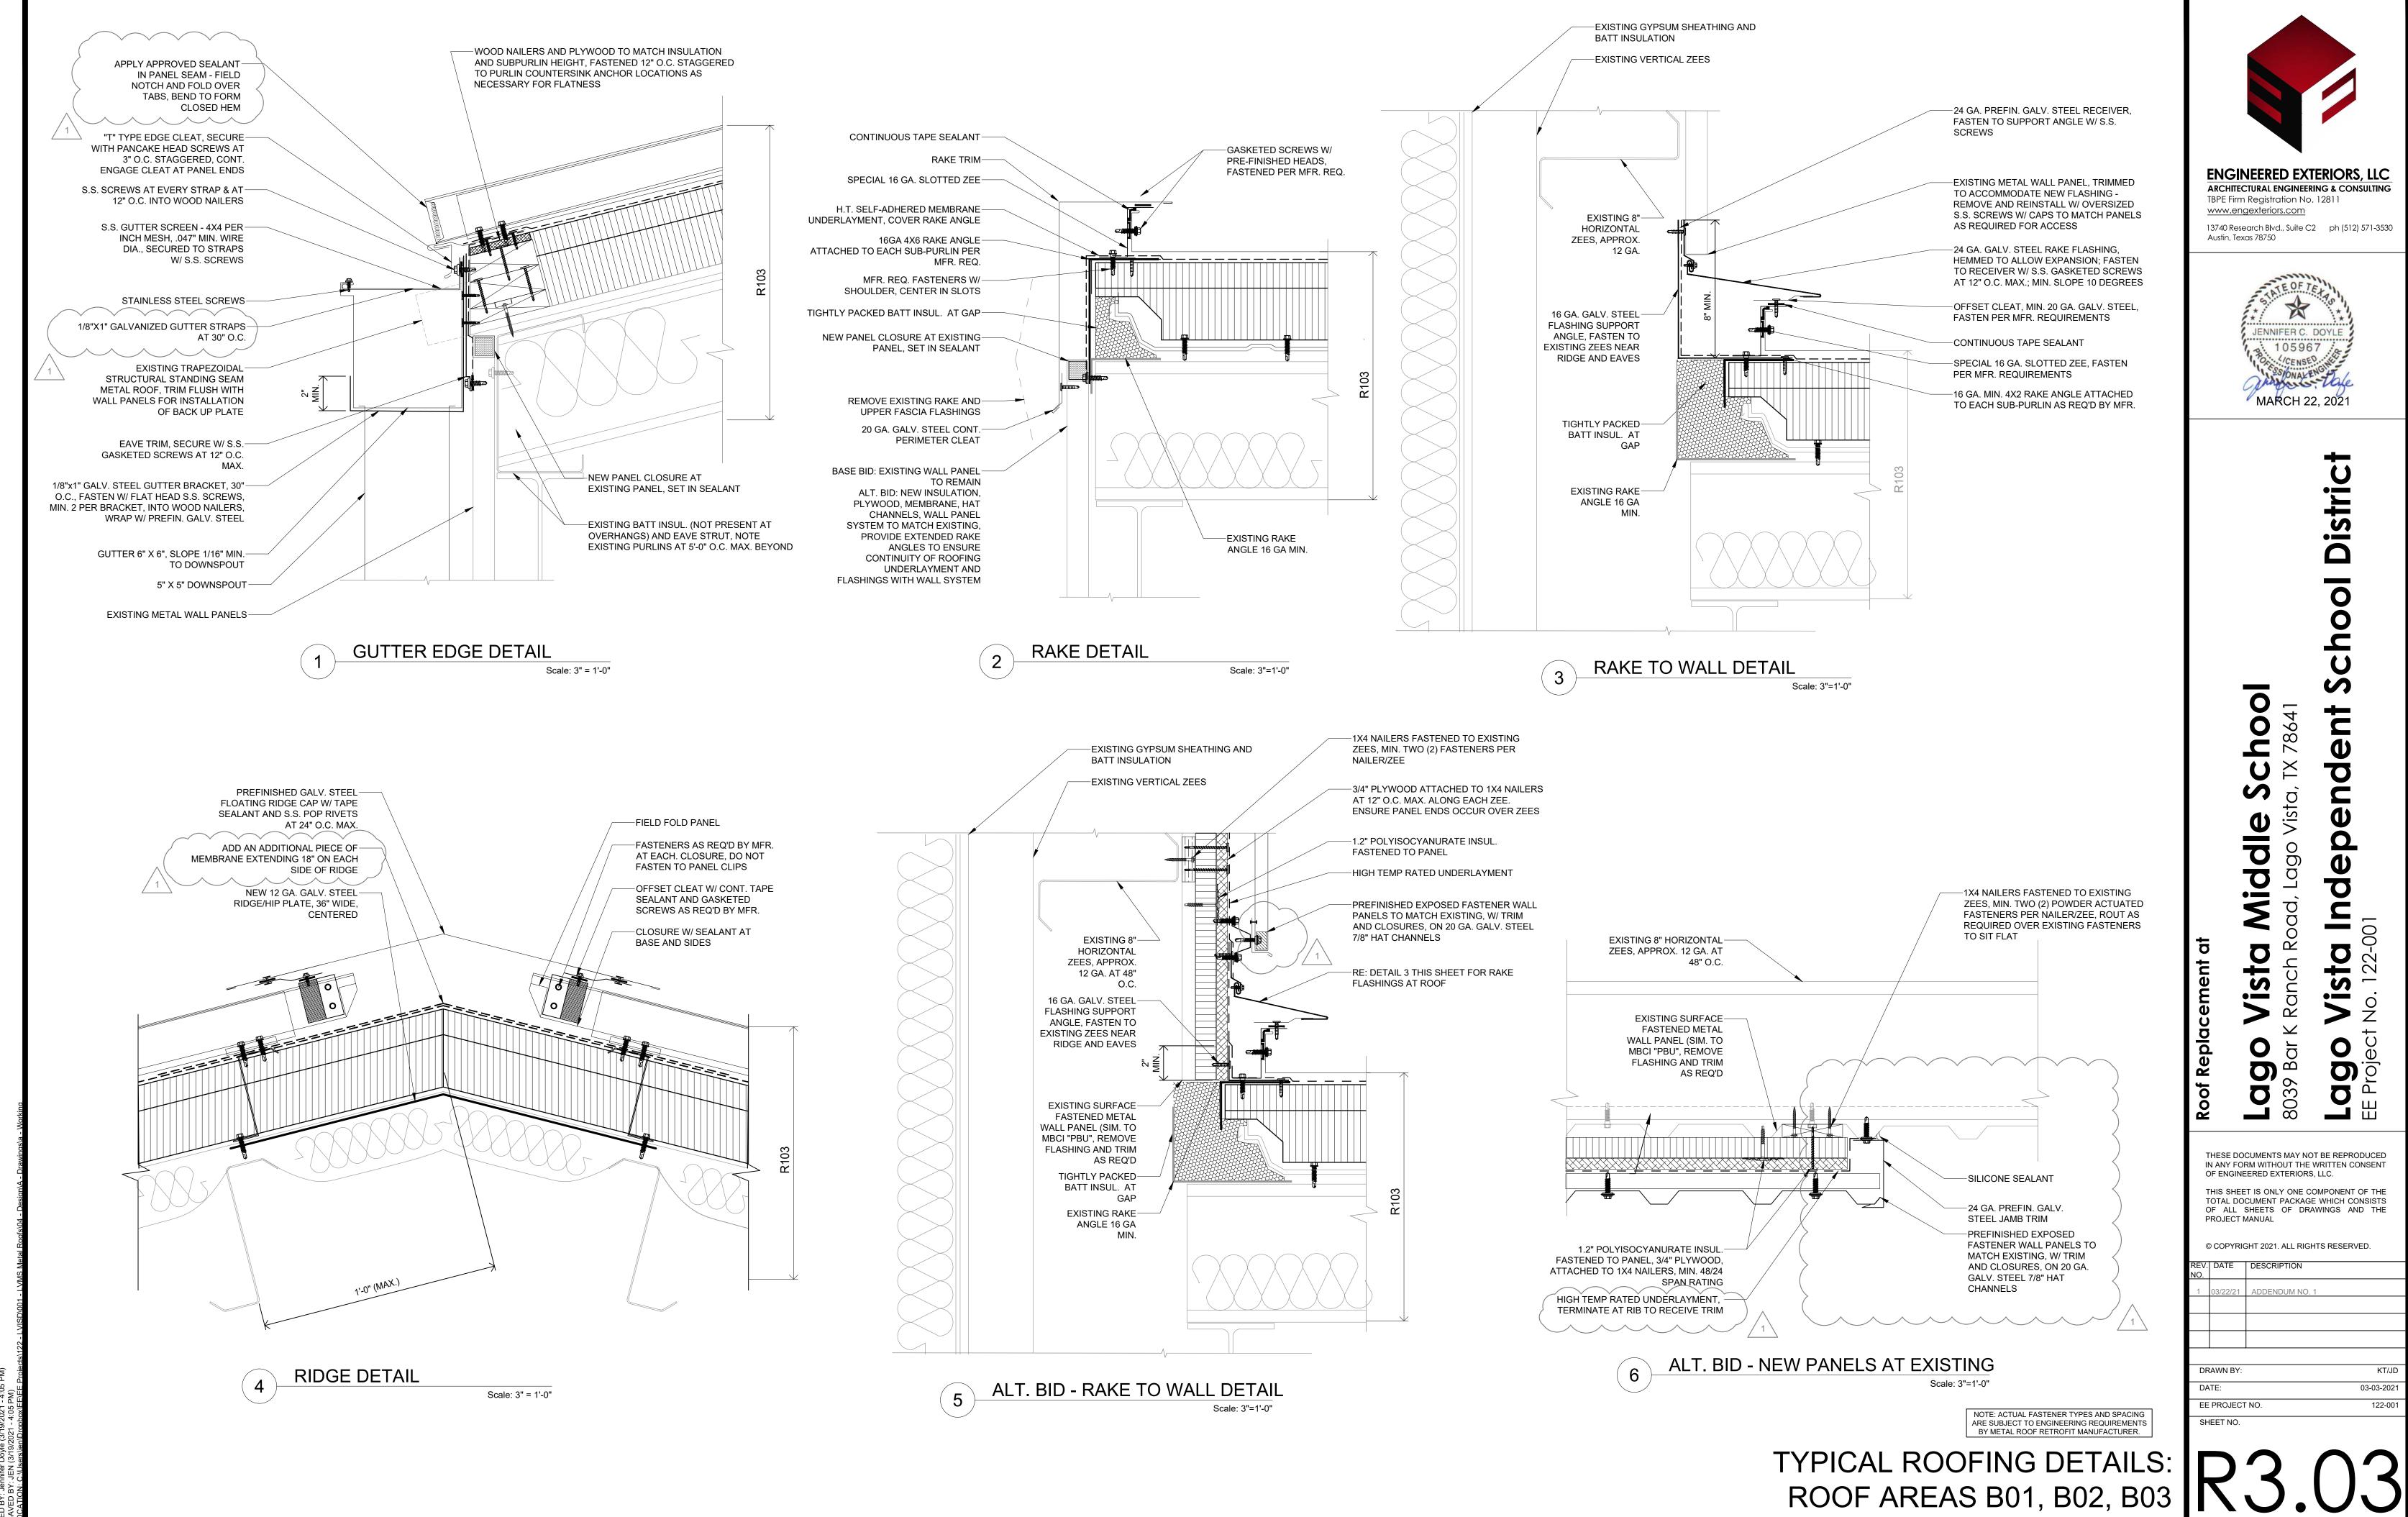

NO.	DATE	DESCRIPTION
1	03/22/21	ADDENDUM NO. 1
DR	DRAWN BY: KT/JD	